


1 LOCATION OF WATER WELL: Fraction SW 1/4 NE 1/4 SE 1/4 Section Number 27 Township Number T 19 S Range Number R 7 E/W

Distance and direction from nearest town or city street address of well if located within city? 1/2 mi S, 1 1/4 mi E, 3/4 mi S from Mitchell, Kans

2 WATER WELL OWNER: Williams Mid-Continent Fractionation & Storage RR#, St. Address, Box #: 1372 7th Ave. Board of Agriculture, Division of Water Resources City, State, ZIP Code: McPherson, Kansas 67460 Application Number:

3 LOCATE WELL'S LOCATION WITH AN "X" IN SECTION BOX:

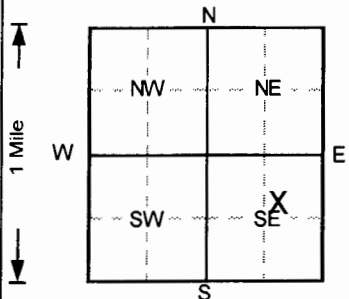

4 DEPTH OF COMPLETED WELL: 43 ft. ELEVATION: 1732.98. Depth(s) Groundwater Encountered: 1. 40 ft. 2. ft. 3. ft. WELL'S STATIC WATER LEVEL: 32.99 ft. below land surface measured on mo/day/yr 8/27/2012. Pump test data: Well water was NA ft. after hours pumping gpm. Est. Yield NA gpm: Well water was ft. after hours pumping gpm. Bore Hole Diameter: 8 in. to 43 ft., and in. to ft. WELL WATER TO BE USED AS: 5 Public water supply 8 Air conditioning 11 Injection well 1 Domestic 3 Feedlot 6 Oil field water supply 9 Dewatering 12 Other (Specify below) 2 Irrigation 4 Industrial 7 Lawn and garden only 10 Monitoring well. Was a chemical/bacteriological sample submitted to Department? Yes No; If yes, mo/day/yr sample was submitted Water Well Disinfected? Yes No

5 TYPE OF BLANK CASING USED: 1 Steel 3 RMP (SR) 5 Wrought iron 8 Concrete tile CASING JOINTS: Glued Clamped 2 PVC 4 ABS 7 Fiberglass 9 Other (specify below) Welded Threaded. Blank casing diameter: 2 in. to 33 ft., Dia in. to ft., Dia in. to ft. Casing height above land surface: 30.72 in., weight lbs./ft. Wall thickness or gauge No. Sch. 40. TYPE OF SCREEN OR PERFORATION MATERIAL: 1 Steel 3 Stainless steel 5 Fiberglass 7 PVC 10 Asbestos-cement 2 Brass 4 Galvanized steel 6 Concrete tile 8 RMP (SR) 11 Other (specify) 12 None used (open hole). SCREEN OR PERFORATION OPENINGS ARE: 1 Continuous slot 3 Mill slot 5 Gauzed wrapped 8 Saw cut 11 None (open hole) 2 Louvered shutter 4 Key punched 6 Wire wrapped 9 Drilled holes 10 Other (specify) 7 Torch cut. SCREEN-PERFORATED INTERVALS: From 33 ft. to 43 ft., From ft. to ft., From ft. to ft., From ft. to ft. GRAVEL PACK INTERVALS: From 30 ft. to 43 ft., From ft. to ft., From ft. to ft., From ft. to ft.

6 GROUT MATERIAL: 1 Neat cement 2 Cement grout 3 Bentonite 4 Other Concrete. Grout Intervals: From 0 ft. to 3 ft., From 3 ft. to 20 ft., From 26 ft. to 30 ft. What is the nearest source of possible contamination: 1 Septic tank 4 Lateral lines 7 Pit privy 10 Livestock pens 14 Abandoned water well 2 Sewer lines 5 Cess pool 8 Sewage lagoon 11 Fuel storage 15 Oil well/Gas well 3 Watertight sewer lines 6 Seepage pit 9 Feedyard 12 Fertilizer storage 16 Other (specify below) 13 Insecticide storage. Direction from well? How many feet?

Table with columns: FROM, TO, LITHOLOGIC LOG, FROM, TO, PLUGGING INTERVALS. Rows include: 0-7 Hydroexcavated, No Sample; 7-10 Clay, silty, Lt. Brown; 10-20 Clay, Lt. Brown to Yellow Brown; 20-29.5 Clay, Yellow Brown to Dark Yellow Brown; 29.5-40 Clay, sl. silty, Yellow Brown; 40-43 Shale, Yellow mottled Dark Brown; MW11-1, Abovegrade.

7 CONTRACTOR'S OR LANDOWNER'S CERTIFICATION: This water well was 1 constructed, 2 reconstructed, or 3 plugged under my jurisdiction and was completed on (mo/day/year) 8/8/2012 and this record is true to the best of my knowledge and belief. Kansas Water Well Contractor's License No. 527. This Water Well Record was completed on (mo/day/yr) 9/5/12 under the business name of GeoCore, Inc. by (signature) Dale Kell