


1 LOCATION OF WATER WELL: Fraction SW 1/4 NE 1/4 SE 1/4 Section Number 27 Township Number T 19 S Range Number R 7 **E/W**

Distance and direction from nearest town or city street address of well if located within city?
 1/2 mi S, 1 1/4 mi E, 3/4 mi S from Mitchell, Kans

2 WATER WELL OWNER: Williams Mid-Continent Fractionation & Storage
 RR#, St. Address, Box # : 1372 7th Ave. Board of Agriculture, Division of Water Resources
 City, State, ZIP Code : McPherson, Kansas 67460 Application Number:

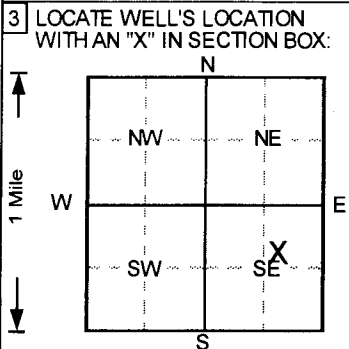

4 DEPTH OF COMPLETED WELL 42 ft ELEVATION: 1733.33
 Depth(s) Groundwater Encountered 1. 35 ft 2. ft 3. ft
 WELL'S STATIC WATER LEVEL 31.76 ft. below land surface measured on mo/day/yr 8/27/2012
 Pump test data: Well water was NA ft. after hours pumping gpm
 Est. Yield NA gpm; Well water was ft. after hours pumping gpm
 Bore Hole Diameter 8 in. to 42 ft. and in. to ft.
 WELL WATER TO BE USED AS:
 5 Public water supply 8 Air conditioning 11 Injection well
 1 Domestic 3 Feedlot 6 Oil field water supply 9 Dewatering 12 Other (Specify below)
 2 Irrigation 4 Industrial 7 Lawn and garden only 10 Monitoring well
 Was a chemical/bacteriological sample submitted to Department? Yes No ; If yes, mo/day/yr sample was submitted
 Water Well Disinfected? Yes No

5 TYPE OF BLANK CASING USED:
 1 Steel 3 RMP (SR) 5 Wrought iron 8 Concrete tile CASING JOINTS: Glued Clamped
 2 PVC 4 ABS 6 Asbestos-Cement 9 Other (specify below) Welded
 7 Fiberglass Threaded
 Blank casing diameter 2 in. to 32 ft., Dia. in. to ft., Dia. in. to ft.
 Casing height above land surface 30.24 in., weight lbs./ft. Wall thickness or gauge No. Sch. 40
 TYPE OF SCREEN OR PERFORATION MATERIAL
 1 Steel 3 Stainless steel 5 Fiberglass 7 PVC 10 Asbestos-cement
 2 Brass 4 Galvanized steel 6 Concrete tile 8 RMP (SR) 11 Other (specify)
 12 None used (open hole)
 SCREEN OR PERFORATION OPENINGS ARE:
 1 Continuous slot 3 Mill slot 5 Gauzed wrapped 8 Saw cut 11 None (open hole)
 2 Louvered shutter 4 Key punched 6 Wire wrapped 9 Drilled holes
 7 Torch cut 10 Other (specify)
 SCREEN-PERFORATED INTERVALS: From 32 ft. to 42 ft., From ft. to ft.
 GRAVEL PACK INTERVALS: From 30 ft. to 42 ft., From ft. to ft.

6 GROUT MATERIAL: 1 Neat cement 2 Cement grout 3 Bentonite 4 Other Concrete
 Grout Intervals: From 0 ft. to 2 ft., From 2 ft. to 27 ft., From 27 ft. to 30 ft.
 What is the nearest source of possible contamination:
 1 Septic tank 4 Lateral lines 7 Pit privy 10 Livestock pens 14 Abandoned water well
 2 Sewer lines 5 Cess pool 8 Sewage lagoon 11 Fuel storage 15 Oil well/Gas well
 3 Watertight sewer lines 6 Seepage pit 9 Feedyard 12 Fertilizer storage 16 Other (specify below)
 13 Insecticide storage
 Direction from well? How many feet?

FROM	TO	LITHOLOGIC LOG	FROM	TO	PLUGGING INTERVALS
0	7	Hydroexcavated, No Sample,			
7	15	Clay, silty, Lt. Brown			
15	20	Clay, silty, Lt. Brown to Yellow Brown			
20	30	Clay, decr. silty, Yellow Brown			
30	35	Clay, V. Lt. Brown to Lt. Yellow Brown			
35	38	Clay w/saturated lenses, Lt. Brown			
38	42	Shale, Yellow mottled Gray and Dark Brown			
					MW11-2, Abovegrade

7 CONTRACTOR'S OR LANDOWNER'S CERTIFICATION: This water well was (1) constructed, (2) reconstructed, or (3) plugged under my jurisdiction and was completed on (mo/day/year) 8/8/2012 and this record is true to the best of my knowledge and belief.
 Kansas Water Well Contractor's License No. 527 This Water Well Record was completed on (mo/day/yr) 9/5/12
 under the business name of GeoCore, Inc. by (signature) Dale Keld