

WATER WELL RECORD


Form WWC-5

Division of Water Resources App. No.

1 LOCATION OF WATER WELL: County: Rice, Fraction NE 1/4 NW 1/4 NE 1/4 NE 1/4, Section Number 19, Township No. T 19 S, Range Number R 7

Street/Rural Address of Well Location; if unknown, distance & direction from nearest town or intersection: Hunter Blvd. to 56 HWY In(Ave. J) 2 1/4W SSR. Global Positioning System (GPS) information: Latitude: 38.39049, Longitude: 098.12967, Elevation: 1750

2 WATER WELL OWNER: Chris Wilson, RR#, Street Address, Box #: 1990 Ave. J, City, State, ZIP Code: Lvons, Kansas 67554. Collection Method: GPS unit (Make/Model: Garmin 62s), Digital Map/Photo, Topographic Map, Land Survey

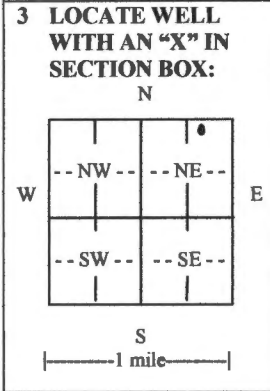

3 LOCATE WELL WITH AN 'X' IN SECTION BOX: N, W, E, S. 4 DEPTH OF COMPLETED WELL 75 ft. Depth(s) Groundwater Encountered (1) 34 ft. (2) ft. (3) ft. WELL'S STATIC WATER LEVEL 34 ft. below land surface measured on mo/day/yr. 3/23/2016. Pump test data: Well water was... ft. after... hours pumping... gpm. EST. YIELD... gpm. Well water was... ft. after... hours pumping... gpm. Bore Hole Diameter 9.7/8 in. to .75 ft., and... in. to... ft. WELL WATER TO BE USED AS: Public water supply, Geothermal, Injection well, Domestic, Feedlot, Oil field water supply, Dewatering, Other (Specify below), Irrigation, Industrial, Domestic-lawn & garden, Monitoring well. Was a chemical/bacteriological sample submitted to Department? Yes No. If yes, mo/day/yr sample was submitted... Water well disinfected? Yes No

5 TYPE OF CASING USED: Steel, PVC, Other. CASING JOINTS: Glued, Clamped, Welded, Threaded. Casing diameter .5 in. to .34 ft., Diameter... in. to... ft., Diameter... in. to... ft. Casing height above land surface .18 in., Weight .160 lbs./ft., Wall thickness or gauge No. 214. TYPE OF SCREEN OR PERFORATION MATERIAL: Steel, Stainless Steel, PVC, Brass, Galvanized Steel, None used (open hole). SCREEN OR PERFORATION OPENINGS ARE: Continuous slot, Mill slot, Gauze wrapped, Torch cut, Drilled holes, None (open hole), Louvered shutter, Key punched, Wire wrapped, Saw cut, Other (specify). SCREEN-PERFORATED INTERVALS: From .34 ft. to .74 ft., From... ft. to... ft., From... ft. to... ft. GRAVEL PACK INTERVALS: From .74 ft. to .20 ft., From... ft. to... ft., From... ft. to... ft.

6 GROUT MATERIAL: Neat cement, Cement grout, Bentonite, Other. Grout Intervals: From .20 ft. to .0 ft., From... ft. to... ft., From... ft. to... ft. What is the nearest source of possible contamination: Septic tank, Lateral lines, Pit privy, Livestock pens, Insecticide storage, Other (specify below), Sewer lines, Cesspool, Sewage lagoon, Fuel storage, Abandoned water well, Watertight sewer lines, Seepage pit, Feedyard, Fertilizer storage, Oil well/gas well, old well. Direction from well north, Distance from well 20'

Table with columns: FROM, TO, LITHOLOGIC LOG, FROM, TO, LITHO. LOG (cont.) or PLUGGING INTERVALS. Rows: 0-3 Top soil, 3-10 Brown clay - tight, 10-25 Tan clay - silty, 25-65 Tan clay - caliche mix w/ strks. of hard caliche, 65-72 Tan clay - hard caliche, ironaid rock peices, 72-75 Tanish yellow clay, 75 Shale gray

7 CONTRACTOR'S OR LANDOWNER'S CERTIFICATION: This water well was constructed, reconstructed, or plugged under my jurisdiction and was completed on (mo/day/year) 3/23/2016 and this record is true to the best of my knowledge and belief. Kansas Water Well Contractor's License No. 134. This Water Well Record was completed on (mo/day/year) 3/29/2016 under the business name of Rosencrantz-Bemis Ent. by (signature) Chris Wilson

INSTRUCTIONS: Use typewriter or ball point pen. PLEASE PRESS FIRMLY and PRINT clearly. Please fill in blanks and check the correct answers. Send three copies (white, blue, pink) to Kansas Department of Health and Environment, Bureau of Water, Geology Section, 1000 SW Jackson St., Suite 420, Topeka, Kansas 66612-1367. Telephone 785-296-5524. Send one copy to WATER WELL OWNER and retain one for your records. I include fee of \$5.00 for each constructed well. Visit us at http://www.kdheks.gov/waterwell/index.html.