


1 LOCATION OF WATER WELL: County: Rice Fraction: NW 1/4 SW 1/4 NW 1/4 Section Number: 13 Township Number: T 19 S Range Number: R 7 NW

Distance and direction from nearest town or city street address of well if located within city?
2 M West of Little River, Ks.

2 WATER WELL OWNER: DARRELL KELSO
 RR#, St. Address, Box #: Box 347 Board of Agriculture, Division of Water Resources
 City, State, ZIP Code: CHASE, Ks. 67524 Application Number:

3 LOCATE WELL'S LOCATION WITH AN "X" IN SECTION BOX: 4 DEPTH OF COMPLETED WELL: 100 ft. ELEVATION:

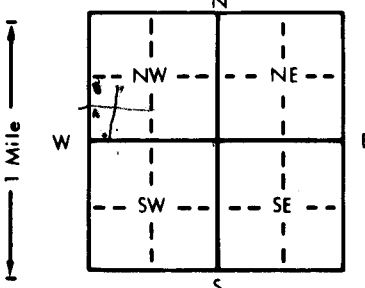

Depth(s) Groundwater Encountered 1. ft. 2. ft. 3. ft.
 WELL'S STATIC WATER LEVEL: 50 ft. below land surface measured on mo/day/yr
 Pump test data: Well water was ft. after hours pumping gpm
 Est. Yield gpm: Well water was ft. after hours pumping gpm
 Bore Hole Diameter: 8 in. to ft., and in. to ft.
 WELL WATER TO BE USED AS:
 Domestic 3 Feedlot 6 Oil field water supply 9 Dewatering 12 Other (Specify below)
 Irrigation 4 Industrial 7 Lawn and garden only 10 Observation well
 Was a chemical/bacteriological sample submitted to Department? Yes No; If yes, mo/day/yr sample was submitted
 Water Well Disinfected? Yes No

5 TYPE OF BLANK CASING USED:
 Steel 3 RMP (SR) 5 Wrought iron 8 Concrete tile CASING JOINTS: glued Clamped
 PVC 4 ABS 6 Asbestos-Cement 9 Other (specify below) Welded
 Fiberglass Threaded

Blank casing diameter: 5 in. to 80 ft., Dia. in. to ft., Dia. in. to ft.
 Casing height above land surface: in., weight lbs./ft. Wall thickness or gauge No.

TYPE OF SCREEN OR PERFORATION MATERIAL:
 Steel 3 Stainless steel 5 Fiberglass 8 RMP (SR) 10 Asbestos-cement
 Brass 4 Galvanized steel 6 Concrete tile 9 ABS 11 Other (specify)
 Mill slot 12 None used (open hole)

SCREEN OR PERFORATION OPENINGS ARE:
 Continuous slot Mill slot 5 Gauzed wrapped 8 Saw cut 11 None (open hole)
 Louvered shutter 4 Key punched 6 Wire wrapped 9 Drilled holes
 Torch cut 10 Other (specify)

SCREEN-PERFORATED INTERVALS: From 80 ft. to 100 ft., From ft. to ft.
 GRAVEL PACK INTERVALS: From 13 ft. to 100 ft., From ft. to ft.

6 GROUT MATERIAL: Neat cement 2 Cement grout 3 Bentonite 4 Other
 Grout Intervals: From 8 ft. to 13 ft., From ft. to ft., From ft. to ft.

What is the nearest source of possible contamination:
 Septic tank 4 Lateral lines 7 Pit privy 11 Fuel storage 15 Oil well/Gas well
 Sewer lines 5 Cess pool 8 Sewage lagoon 12 Fertilizer storage 16 Other (specify below)
 Watertight sewer lines 6 Seepage pit 9 Feedyard 13 Insecticide storage

Direction from well? How many feet?

FROM	TO	LITHOLOGIC LOG	FROM	TO	LITHOLOGIC LOG
0	3	Top Soil			
3	36	Clay			
36	100	Clay + SAND STOVE STREAKS			

7 CONTRACTOR'S OR LANDOWNER'S CERTIFICATION: This water well was constructed, (2) reconstructed, or (3) plugged under my jurisdiction and was completed on (mo/day/year) 9-4-85 and this record is true to the best of my knowledge and belief. Kansas Water Well Contractor's License No. 462 This Water Well Record was completed on (mo/day/yr) 9-9-85 under the business name of Samb Water Well Service by (signature) Sam Rayburn

INSTRUCTIONS: Use typewriter or ball point pen, PLEASE PRESS FIRMLY and PRINT clearly. Please fill in blanks, underline or circle the correct answers. Send top three copies to Kansas Department of Health and Environment, Division of Environment, Environmental Geology Section, Topeka, KS 66620. Send one to WATER WELL OWNER and retain one for your records.