Plot

USE TYPEWRITER OR BALL POINT PEN-PRESS FIRMLY, PRINT CLEARLY.

T R EW sec 1/4 1/4 1/4 No.

WATER WELL RECORD
KSA 82a-1201-1215

Kansas State Dept. Of Health
(Water Well Contractors)
Forbes-Bldg. 740
Topeka, Kansas 66620

1 Location of well:	County: Rice	Township name: mitchell	Fraction: NW¼ SW¼	Section number: 30	Town number: 19-S	Range number: 7-W

Distance and direction from nearest town or city: 2 miles of Lyons town

Street address of well location if in city:

3 Owner of well: Ben Hosch

Address: Lyons Kans. R.F.D.

Locate with "X" in section below:

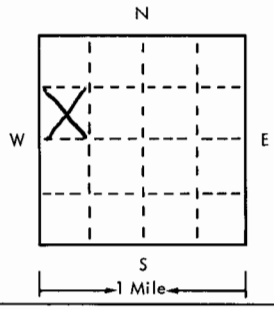

Sketch map:

4 Well depth: 107 ft. Date of completion 10-24-75
Well diameter 9 in.

5 ☒ Cable tool ☐ Rotary ☐ Driven ☐ Dug
☐ Hollow rod ☐ Jetted ☐ Bored ☐ Reverse rotary

6 Use: ☒ Domestic ☐ Public supply ☐ Industry
☐ Irrigation ☐ Air conditioning ☐ Commercial
☐ Test well ☒ Human stock

7 Casing: Material PVC Height: above/below
Threaded ☐ Welded ☒ Surface 12 in.
Diam. 6 in. to 107 ft. depth Weight 4 lbs./ft. 1
___ in. to ___ ft. depth Drive shoe? ☐ Yes ☒ No

2 Type and color of material	From	To
Soil	0	5
Clay	5	55
Sandy clay	55	70
Water Bearing clay	70	105
Blue Shale	105	107

(use a second sheet if needed)

8 Screen:
Manufacturer Cententeed
Type Plast PVC Dia. 6 in.
Slot/gauze 1/16 in Length 35
Set between 70 ft. and 105 ft.
Fittings:
Gravel pack ☒ Yes ☐ No Size range of material 1/4

9 Static water level:
42 ft. below land surface Date 10-24-75

10 Pumping level below land surfaces:
___ ft. after ___ hrs. pumping ___ g.p.m.
___ ft. after ___ hrs. pumping ___ g.p.m.
Estimated maximum yield 30 g.p.m.

11 Water sample submitted:
☐ Yes ☒ No Date ___

12 Well head completion:
☐ Pitless adapter ☒ Inches above grade

13 Well grouted? ☒ Yes ☐ No
☒ Neat cement ☐ Bentonite ☐ ___
Depth: From 0 ft. to 10 ft.

14 Nearest source of possible contamination:
ft. 1500 Direction N Type good
Well disinfected upon completion? ☒ Yes ☐ No

15 Pump: ☒ Not installed
Manufacturer's name ___
Model number ___ HP ___ Volts ___
Length of drop pipe ___ ft. capacity ___ g.m.p.
Type:
☐ Submersible ☐ Turbine
☐ Jet ☐ Reciprocating
☐ Certrifugal ☐ Other

16 Remarks: elevation

Topography:
☐ Hill
☐ Slope
☒ Upland
☐ Valley

17 Water well contractor's certification:
This well was drilled under my jurisdiction and this report is true to the best of my knowledge and belief.
Arthur Varney 147
Business name License No.
Address Lyons Kans. R.1
Signed Arthur Varney Date 10-24-75
Authorized representative

19 7W 30 SWNW

Forward the white, blue and pink copies to the Kansas State Dept. Of Health.

Form WWC-5