


1 LOCATION OF WATER WELL: County: Rice	Fraction NE 1/4 SE 1/4 NW 1/4	Section Number 30	Township Number T 19 S	Range Number R 7 E/W
---	----------------------------------	----------------------	---------------------------	-------------------------

Distance and direction from nearest town or city street address of well if located within city?  
Approximately 3 1/2 miles east and 1 3/4 miles north of Lyons

2 WATER WELL OWNER: Dennis Suhler  
Lyons Trailer Wash, Inc.  
RR#, St. Address, Box #: 1940 U.S. Hwy 56  
City, State, ZIP Code: Lyons, KS 67554  
Board of Agriculture, Division of Water Resources  
Application Number: 939138 TERM PERMIT

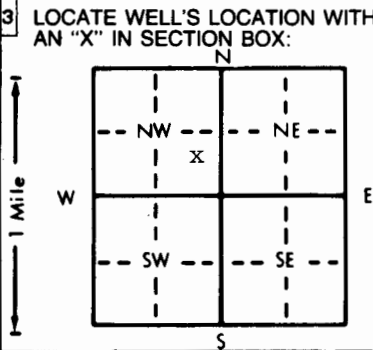

4 DEPTH OF COMPLETED WELL: 112 ft. ELEVATION: unknown  
Depth(s) Groundwater Encountered 1. . . . . ft. 2. . . . . ft. 3. . . . . ft.  
WELL'S STATIC WATER LEVEL . . . 38.3 . . . ft. below land surface measured on mo/day/yr . . . 12-9-93 . . .  
Pump test data: Well water was not ch'd. ft. after . . . . . hours pumping . . . . . gpm  
Est. Yield unknown gpm: Well water was . . . . . ft. after . . . . . hours pumping . . . . . gpm  
Bore Hole Diameter . . . 11 in. to . . . 110 . . . ft., and . . . . . in. to . . . . . ft.  
WELL WATER TO BE USED AS: 5 Public water supply 8 Air conditioning 11 Injection well  
1 Domestic 3 Feedlot 6 Oil field water supply 9 Dewatering 12 Other (Specify below)  
2 Irrigation 4 Industrial 7 Lawn and garden only 10 Monitoring well . . . . .  
Was a chemical/bacteriological sample submitted to Department? Yes . . . . . No  . . . . . If yes, mo/day/yr sample was submitted  
Water Well Disinfected? Yes  No

5 TYPE OF BLANK CASING USED:  
1 Steel 3 RMP (SR) 5 Wrought iron 8 Concrete tile CASING JOINTS: Glued  Clamped . . . . .  
2 PVC 4 ABS 6 Asbestos-Cement 9 Other (specify below) Welded . . . . .  
7 Fiberglass . . . . . Threaded . . . . .  
Blank casing diameter . . . 5 . . . in. to . . . 90 . . . ft., Dia . . . . . in. to . . . . . ft., Dia . . . . . in. to . . . . . ft.  
Casing height above land surface . . . 24 . . . in., weight . . . 2.36 . . . lbs./ft. Wall thickness or gauge No. . . . 214 . . .  
TYPE OF SCREEN OR PERFORATION MATERIAL:  
1 Steel 3 Stainless steel 5 Fiberglass 7 PVC 10 Asbestos-cement  
2 Brass 4 Galvanized steel 6 Concrete tile 8 RMP (SR) 11 Other (specify) . . . . .  
9 ABS 12 None used (open hole)  
SCREEN OR PERFORATION OPENINGS ARE:  
1 Continuous slot 3 Mill slot 5 Gauzed wrapped 8 Saw cut 11 None (open hole)  
2 Louvered shutter 4 Key punched 6 Wire wrapped 9 Drilled holes  
7 Torch cut 10 Other (specify) . . . . .  
SCREEN-PERFORATED INTERVALS: From . . . . . 90 . . . ft. to . . . . . 110 . . . ft., From . . . . . ft. to . . . . . ft.  
From . . . . . ft. to . . . . . ft., From . . . . . ft. to . . . . . ft.  
GRAVEL PACK INTERVALS: From . . . . . 28 . . . ft. to . . . . . 70 . . . ft., From . . . . . ft. to . . . . . ft.  
From . . . . . 80 . . . ft. to . . . . . 110 . . . ft., From . . . . . ft. to . . . . . ft.

6 GROUT MATERIAL: 1 Neat cement 2 Cement grout 3 Bentonite 4 Other . . . . . Bentonite Holeplug . . . . .  
Grout Intervals: From . . . . . 0 . . . ft. to . . . . . 5 . . . ft., From . . . . . 5 . . . ft. to . . . . . 28 . . . ft., From . . . . . 70 . . . ft. to . . . . . 80 . . . ft.  
What is the nearest source of possible contamination:  
1 Septic tank 4 Lateral lines 7 Pit privy 10 Livestock pens 14 Abandoned water well  
2 Sewer lines 5 Cess pool 8 Sewage lagoon 11 Fuel storage 15 Oil well/Gas well  
3 Watertight sewer lines 6 Seepage pit 9 Feedyard 12 Fertilizer storage 16 Other (specify below)  
13 Insecticide storage . . . . . None known . . . . .  
Direction from well? How many feet?

FROM	TO	LITHOLOGIC LOG	FROM	TO	PLUGGING INTERVALS
0	4	Topsoil			
4	9	Clay, brown			
9	16	Clay, soft, sandy			
16	32	Clay, hard, white and caliche			
32	50	Clay, brown mixed with caliche			
50	51	Hard caliche			
51	53	Clay, soft, sandy			
53	70	Clay, hard, brown			
70	78	Clay, tan, sandy with fine sand			
78	94	Clay, hard and caliche			
94	107	Siltstone and sand, fine to medium, clean			
107	110	Shale, blue			

7 CONTRACTOR'S OR LANDOWNER'S CERTIFICATION: This water well was (1) constructed, (2) reconstructed, or (3) plugged under my jurisdiction and was completed on (mo/day/year) . . . . . 12-9-93 . . . . . and this record is true to the best of my knowledge and belief. Kansas Water Well Contractor's License No. . . . . 185 . . . . . This Water Well Record was completed on (mo/day/yr) . . . . . 12-23-93 . . . . . under the business name of Clarke Well & Equipment, Inc. by (signature) *Clarke*