

CORRECTION(S) TO WATER WELL RECORD (WWC-5)
(to rectify lacking or incorrect information)

County: Rice

Location listed as:

Section-Township-Range: 33-195-18E

Fraction ($\frac{1}{4}$ $\frac{1}{4}$ $\frac{1}{4}$): SE NE SE

Location changed to:

33-195-8W

NE SE SE

Other changes: Initial statements: _____

Changed to: _____

Comments: _____

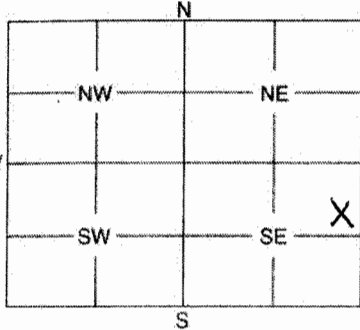
verification method: Well address, city map on internet, and
Lyons 1:24,000 topo. map.

initials: ARL date: 6/28/2005

1	LOCATION OF WATER WELL: County: Rice	Fraction SE 1/4 NE 1/4 SE 1/4	Section Number 33	Township Number 19S	Range Number 8
---	--	---	-----------------------------	-------------------------------	--------------------------

Distance and direction from nearest town or city street address of well if located within city?
321 Grand., Lyons, Kansas

2 WATER WELL OWNER: **Farmers Coop Union**
 RR #, St. Address, Box #: **P.O. Box 159**
 City, State, ZIP Code: **Sterling, Ks 67579**
 Board of Agriculture, Division of Water Resources
 Application Number:

3	MARK WELL'S LOCATION WITH AN "X" IN SECTION BOX: 	4	DEPTH OF WELL 20 ft. WELL'S STATIC WATER LEVEL dry ft. WELL WAS USED AS: 1 Domestic 2 Irrigation 3 Feedlot 4 Industrial 5 Public Water Supply 6 Oil Field Water Supply 7 Domestic (Lawn & Garden) 8 Air Conditioning 9 Dewatering 10 Monitoring Well 11 Injection Well 12 Other..... Was a chemical / bacteriological sample submitted to Department? Yes No X If yes, mo/day/yr sample was submitted Water Well Disinfected: Yes No X
---	---	---	--

5 TYPE OF BLANK CASING USED:
 1 Steel 3 RMP (SR) 5 Wrought 7 Fiberglass 9 Other (Specify below)
 2 **PVC** 4 ABS 6 Asbestos-Cement 8 Concrete Tile

Blank casing diameter in. Was casing pulled? Yes **X**..... No If yes, how much.....
 Casing height above or below land surface in.

6 GROUT PLUG MATERIAL: **3** Neat cement 2 Cement grout **3** Bentonite **4** Other.....**Surface silts and clays**.....
 Grout Plug Intervals: From **20**..... ft. to **3**..... ft., From **3**..... ft. to **0**..... ft., From..... to..... ft.

What is the nearest source of possible contamination:
 1 Septic tank 6 Seepage pit 11 Fuel storage 16 Other (specify below) **cont. site**
 2 Sewer lines 7 Pit privy 12 Fertilizer storage
 3 Watertight sewer lines 8 Sewage lagoon 13 Insecticide storage
 4 Lateral lines 9 Feedyard 14 Abandoned water well
 5 Cess pool 10 Livestock pens 15 Oil well/Gas well

Direction from well? How many feet?

FROM	TO	PLUGGING MATERIALS
20	3	Bentonite
3	0	Surface Silts/Clays Grass seed

7 CONTRACTOR'S OF LANDOWNER'S CERTIFICATION: This water well was plugged under my jurisdiction and was completed on (mo/day/year) **04/21/05** and this record is true to the best of my knowledge and belief. Kansas Water Well Contractor's License No. **585** This Water Well Record was completed on (mo/day/year) **05/21/05** under the business name of **Associated Environmental, Inc.**
 by (signature) **B. Johnson**

INSTRUCTIONS: Use typewriter or ball point pen. Please press firmly and print clearly. Please fill in blanks, underline or circle the correct answers. Send top three copies to Kansas Department of Health and Environment, Bureau of Water, Geology Section, 1000 SW Jackson St., Ste. 420, Topeka, Kansas 66612-1367. Telephone: 785/296-5522. Send one to Water Well Owner and retain one for your records.