


1	LOCATION OF WATER WELL:	Fraction	Section	Number	Township	Number	Range	Number
	County: Rice	SE ¼ NE ¼ SW ¼		33		19		8

EW

Distance and direction from nearest town or city street address of well if located within city?
 North Logan Street, Lyons

2	WATER WELL OWNER: RICE COUNTY HIGHWAY DEP'T	Board of Agriculture, Division of Water Resources
	RR #, St. Address, Box #: RR 3, Box 32	Application Number:
	City, State, ZIP Code : Lyons, KS 67554	

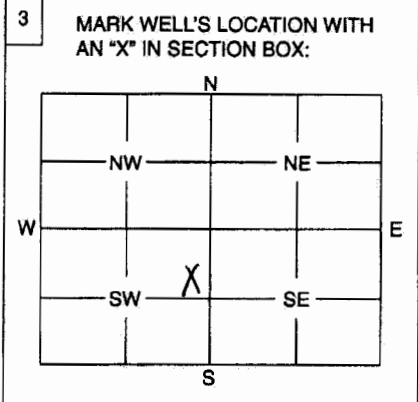

4	DEPTH OF WELL 42.25 ft.												
	WELL'S STATIC WATER LEVEL N/A ft.												
	WELL WAS USED AS:												
	<table style="width:100%; border:none;"> <tr> <td style="width:33%;">1 Domestic</td> <td style="width:33%;">5 Public Water Supply</td> <td style="width:33%;">9 Dewatering</td> </tr> <tr> <td>2 Irrigation</td> <td>6 Oil Field Water Supply</td> <td><input checked="" type="radio"/> Monitoring Well</td> </tr> <tr> <td>3 Feedlot</td> <td>7 Domestic (Lawn & Garden)</td> <td>11 Injection Well</td> </tr> <tr> <td>4 Industrial</td> <td>8 Air Conditioning</td> <td>12 Other</td> </tr> </table>	1 Domestic	5 Public Water Supply	9 Dewatering	2 Irrigation	6 Oil Field Water Supply	<input checked="" type="radio"/> Monitoring Well	3 Feedlot	7 Domestic (Lawn & Garden)	11 Injection Well	4 Industrial	8 Air Conditioning	12 Other
1 Domestic	5 Public Water Supply	9 Dewatering											
2 Irrigation	6 Oil Field Water Supply	<input checked="" type="radio"/> Monitoring Well											
3 Feedlot	7 Domestic (Lawn & Garden)	11 Injection Well											
4 Industrial	8 Air Conditioning	12 Other											
	Was a chemical / bacteriological sample submitted to Department? Yes No <input checked="" type="checkbox"/>												
	If yes, mo/day/yr sample was submitted												
	Water Well Disinfected: Yes No <input checked="" type="checkbox"/>												

5	TYPE OF BLANK CASING USED:	<table style="width:100%; border:none;"> <tr> <td>1 Steel</td> <td>3 RMP (SR)</td> <td>5 Wrought</td> <td>7 Fiberglass</td> <td>9 Other (Specify below)</td> </tr> <tr> <td><input checked="" type="radio"/> PVC</td> <td>4 ABS</td> <td>6 Asbestos-Cement</td> <td>8 Concrete Tile</td> <td>.....</td> </tr> </table>	1 Steel	3 RMP (SR)	5 Wrought	7 Fiberglass	9 Other (Specify below)	<input checked="" type="radio"/> PVC	4 ABS	6 Asbestos-Cement	8 Concrete Tile
1 Steel	3 RMP (SR)	5 Wrought	7 Fiberglass	9 Other (Specify below)								
<input checked="" type="radio"/> PVC	4 ABS	6 Asbestos-Cement	8 Concrete Tile								
	Blank casing diameter 2 in.	Was casing pulled? Yes No <input checked="" type="checkbox"/>										
	Casing height above or below land surface N/A in.	If yes, how much 3' <i>Drilled out to 3'</i>										

6	GROUT PLUG MATERIAL:	<table style="width:100%; border:none;"> <tr> <td>1 Neat cement</td> <td>2 Cement grout</td> <td><input checked="" type="radio"/> Bentonite</td> <td><input checked="" type="radio"/> Other ..Native soil.....</td> </tr> </table>	1 Neat cement	2 Cement grout	<input checked="" type="radio"/> Bentonite	<input checked="" type="radio"/> Other ..Native soil.....																
1 Neat cement	2 Cement grout	<input checked="" type="radio"/> Bentonite	<input checked="" type="radio"/> Other ..Native soil.....																			
	GROUT PLUG INTERVALS:	From 0 ft. to 3 ft., From 3 ft. to 42.25 ft., From to ft.																				
	What is the nearest source of possible contamination:	<table style="width:100%; border:none;"> <tr> <td>1 Septic tank</td> <td>6 Seepage pit</td> <td>11 Fuel storage</td> <td>16 Other (specify below)</td> </tr> <tr> <td>2 Sewer lines</td> <td>7 Pit privy</td> <td>12 Fertilizer storage</td> <td>.....</td> </tr> <tr> <td>3 Watertight sewer lines</td> <td>8 Sewage lagoon</td> <td>13 Insecticide storage</td> <td></td> </tr> <tr> <td>4 Lateral lines</td> <td>9 Feedyard</td> <td>14 Abandoned water well</td> <td></td> </tr> <tr> <td>5 Cess pool</td> <td>10 Livestock pens</td> <td>15 Oil well/Gas well</td> <td></td> </tr> </table>	1 Septic tank	6 Seepage pit	11 Fuel storage	16 Other (specify below)	2 Sewer lines	7 Pit privy	12 Fertilizer storage	3 Watertight sewer lines	8 Sewage lagoon	13 Insecticide storage		4 Lateral lines	9 Feedyard	14 Abandoned water well		5 Cess pool	10 Livestock pens	15 Oil well/Gas well	
1 Septic tank	6 Seepage pit	11 Fuel storage	16 Other (specify below)																			
2 Sewer lines	7 Pit privy	12 Fertilizer storage																			
3 Watertight sewer lines	8 Sewage lagoon	13 Insecticide storage																				
4 Lateral lines	9 Feedyard	14 Abandoned water well																				
5 Cess pool	10 Livestock pens	15 Oil well/Gas well																				
	Direction from well?	How many feet?																				

FROM	TO	PLUGGING MATERIALS
0	3	Native soil
3	42.25	Bentonite (2")

MW8
 GeoCore #3
 KDHE #U5 080 00296

7	CONTRACTOR'S OF LANDOWNER'S CERTIFICATION: This water well was plugged under my jurisdiction and was completed on (mo/day/year) 3/15/2007 and this record is true to the best of my knowledge and belief. Kansas Water Well Contractor's License No. 527 This Water Well Record was completed on (mo/day/year) 3/19/2007 under the business name of GeoCore, Inc. by (signature) <i>Dale Kelly</i>
---	---

INSTRUCTIONS: Use typewriter or ball point pen. Please press firmly and print clearly. Please fill in blanks, underline or circle the correct answers. Send top three copies to Kansas Department of Health and Environment, Bureau of Water, Geology Section, 1000 SW Jackson St., Ste. 420, Topeka, Kansas 66612-1367. Telephone: 785/296-5522. Send one to Water Well Owner and retain one for your records.