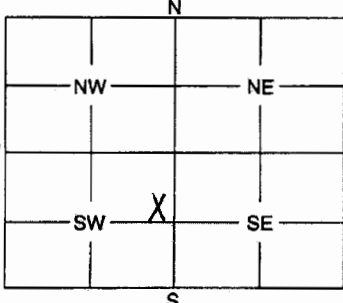


1	LOCATION OF WATER WELL:	Fraction	Section	Number	Township	Number	Range	Number
	County: Rice	SE ¼ NE ¼ SW ¼	33		19		8	EAW

Distance and direction from nearest town or city street address of well if located within city?
 North Logan Street, Lyons

2	WATER WELL OWNER: RICE COUNTY HIGHWAY DEPT	Board of Agriculture, Division of Water Resources
	RR #, St. Address, Box #: RR 3, Box 32	Application Number:
	City, State, ZIP Code : Lyons, KS 67554	

<p>3 MARK WELL'S LOCATION WITH AN "X" IN SECTION BOX:</p> <div style="text-align:center;">  </div>	<p>4 DEPTH OF WELL 42.5 ft.</p> <p>WELL'S STATIC WATER LEVEL N/A ft.</p> <p>WELL WAS USED AS:</p> <table style="width:100%;"> <tr> <td>1 Domestic</td> <td>5 Public Water Supply</td> <td>9 Dewatering</td> </tr> <tr> <td>2 Irrigation</td> <td>6 Oil Field Water Supply</td> <td>10 Monitoring Well</td> </tr> <tr> <td>3 Feedlot</td> <td>7 Domestic (Lawn & Garden)</td> <td>11 Injection Well</td> </tr> <tr> <td>4 Industrial</td> <td>8 Air Conditioning</td> <td>12 Other</td> </tr> </table> <p>Was a chemical / bacteriological sample submitted to Department? Yes No<input checked="" type="checkbox"/></p> <p>If yes, mo/day/yr sample was submitted</p> <p>Water Well Disinfected: Yes No<input checked="" type="checkbox"/></p>	1 Domestic	5 Public Water Supply	9 Dewatering	2 Irrigation	6 Oil Field Water Supply	10 Monitoring Well	3 Feedlot	7 Domestic (Lawn & Garden)	11 Injection Well	

5	TYPE OF BLANK CASING USED:	1 Steel 3 RMP (SR) 5 Wrought 7 Fiberglass 9 Other (Specify below) ● PVC 4 ABS 6 Asbestos-Cement 8 Concrete Tile
	Blank casing diameter 2 in.	Was casing pulled? Yes No <input checked="" type="checkbox"/> If yes, how much 3'
	Casing height above or below land surface N/A in.	<i>Drilled out to 3'</i>

6	GROUT PLUG MATERIAL:	1 Neat cement 2 Cement grout ● Bentonite ● Other ..Native soil..... Grout Plug Intervals: From 0 ft. to 3 ft., From 3 ft. to 42.5 ft., From to ft.
	What is the nearest source of possible contamination:	1 Septic tank 6 Seepage pit 11 Fuel storage 16 Other (specify below) 2 Sewer lines 7 Pit privy 12 Fertilizer storage 3 Watertight sewer lines 8 Sewage lagoon 13 Insecticide storage 4 Lateral lines 9 Feedyard 14 Abandoned water well 5 Cess pool 10 Livestock pens 15 Oil well/Gas well
	Direction from well?	How many feet?

FROM	TO	PLUGGING MATERIALS
0	3	Native soil
3	42.5	Bentonite (2")

MW9
 GeoCore #3
 KDHE #U5 080 00296

7	CONTRACTOR'S OF LANDOWNER'S CERTIFICATION: This water well was plugged under my jurisdiction and was completed on (mo/day/year) 3/15/2007 and this record is true to the best of my knowledge and belief. Kansas Water Well Contractor's License No. 527 This Water Well Record was completed on (mo/day/year) 3/19/2007 under the business name of Geopora, Inc. by (signature) <i>Dave Holt</i>
---	--

INSTRUCTIONS: Use typewriter or ball point pen. Please press firmly and print clearly. Please fill in blanks, underline or circle the correct answers. Send top three copies to Kansas Department of Health and Environment, Bureau of Water, Geology Section, 1000 SW Jackson St., Ste. 420, Topeka, Kansas 66612-1367. Telephone: 785/296-5522. Send one to Water Well Owner and retain one for your records.