

COOK #1


1 LOCATION OF WATER WELL:	Fraction	Section Number	Township Number	Range Number
County: RICE	C 1/4 SE 1/4 SE 1/4	8	T 19 S	R 8 EW

Distance and direction from nearest town or city street address of well if located within city?

POLLARD 1/4 W 2745 WESTSIDE

2 WATER WELL OWNER: B+B DRILLING INC.	MR. COOK, LYONS, KS
RR#, St. Address, Box #: 515 UNION CENTER	Board of Agriculture, Division of Water Resources
City, State, ZIP Code: WICHITA, KS 67202	Application Number: T82-188

3 LOCATE WELL'S LOCATION WITH AN "X" IN SECTION BOX:

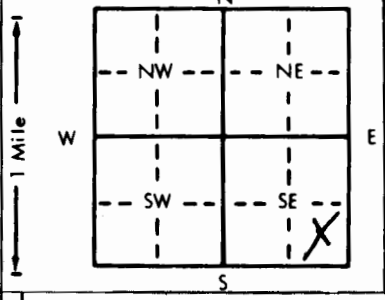

4 DEPTH OF COMPLETED WELL: 60 ft.	ELEVATION:
Depth(s) Groundwater Encountered 1. 30 ft. 2. ft. 3. ft.	
WELL'S STATIC WATER LEVEL 6 ft. below land surface measured on mo/day/yr 3-24-82	
Pump test data: Well water was ft. after hours pumping gpm	
Est. Yield gpm: Well water was ft. after hours pumping gpm	
Bore Hole Diameter 7.718 in. to 6.0 ft., and in. to ft.	
WELL WATER TO BE USED AS:	
5 Public water supply 8 Air conditioning 11 Injection well	
1 Domestic 3 Feedlot 6 Oil field water supply 9 Dewatering 12 Other (Specify below)	
2 Irrigation 4 Industrial 7 Lawn and garden only 10 Observation well	
Was a chemical/bacteriological sample submitted to Department? Yes.....No.....; If yes, mo/day/yr sample was submitted	Water Well Disinfected? Yes No

5 TYPE OF BLANK CASING USED:	5 Wrought iron	8 Concrete tile	CASING JOINTS: Glued <u>XY</u> Clamped
1 Steel 3 RMP (SR)	6 Asbestos-Cement	9 Other (specify below)	Welded
2 PVC 4 ABS	7 Fiberglass		Threaded
Blank casing diameter 5 in. to 40 ft., Dia in. to ft., Dia in. to ft.			
Casing height above land surface 12 in., weight 7.85 lbs./ft. Wall thickness or gauge No. 214			
TYPE OF SCREEN OR PERFORATION MATERIAL:	7 PVC	10 Asbestos-cement	
1 Steel 3 Stainless steel 5 Fiberglass 8 RMP (SR) 11 Other (specify)			
2 Brass 4 Galvanized steel 6 Concrete tile 9 ABS 12 None used (open hole)			
SCREEN OR PERFORATION OPENINGS ARE: 1/8	5 Gauzed wrapped 8 Saw cut 11 None (open hole)		
1 Continuous slot 3 Mill slot 6 Wire wrapped 9 Drilled holes			
2 Louvered shutter 4 Key punched 7 Torch cut 10 Other (specify)			
SCREEN-PERFORATED INTERVALS: From 40 ft. to 60 ft., From ft. to ft.			
GRAVEL PACK INTERVALS: From 30 ft. to 60 ft., From ft. to ft.			

6 GROUT MATERIAL:	1 Neat cement	2 Cement grout	3 Bentonite	4 Other
Grout Intervals: From 0 ft. to 10 ft., From ft. to ft., From ft. to ft.				
What is the nearest source of possible contamination: NONE	10 Livestock pens	14 Abandoned water well		
1 Septic tank 4 Lateral lines 7 Pit privy 11 Fuel storage 15 Oil well/Gas well				
2 Sewer lines 5 Cess pool 8 Sewage lagoon 12 Fertilizer storage 16 Other (specify below)				
3 Watertight sewer lines 6 Seepage pit 9 Feedyard 13 Insecticide storage				
Direction from well?	How many feet?			

FROM	TO	LITHOLOGIC LOG	FROM	TO	LITHOLOGIC LOG
0	3	SOIL			
3	30	CLAY			
30	60	SANDROCK			

7 CONTRACTOR'S OR LANDOWNER'S CERTIFICATION: This water well was (1) constructed, (2) reconstructed, or (3) plugged under my jurisdiction and was completed on (mo/day/year) 3-24-82 and this record is true to the best of my knowledge and belief. Kansas Water Well Contractor's License No. 389 This Water Well Record was completed on (mo/day/yr) 4-5-82 under the business name of REISER WATER WELL SETU. INC. by (signature) Rudolph Reiser
--

INSTRUCTIONS: Use typewriter or ball point pen, PLEASE PRESS FIRMLY and PRINT clearly. Please fill in blanks, underline or circle the correct answers. Send top three copies to Kansas Department of Health and Environment, Division of Environment, Environmental Geology Section, Topeka, KS 66620. Send one to WATER WELL OWNER and retain one for your records.