Plo

USE TYPEWRITER OR BALL POINT PEN-PRESS FIRMLY, PRINT CLEARLY.

WATER WELL RECORD
KSA 82a-1201-1215

Kansas Department of Health and Environment-Division of Environment
(Water well Contractors)
Topeka, Kansas 66620

1. Location of well:	County	Fraction	Section number	Township number	Range number
	Rice	DDC SW 1/4 SE 1/4 SE 1/4	29	T 19 S	R 8 E/W

2. Distance and direction from nearest town or city:
1 mile Northwest of Lyons, KS
Street address of well location if in city:

3. Owner of well: John Feldman
R.R. or street: Route 3
City, state, zip code: Lyons, KS 67554

4. Locate with "X" in section below: Sketch map:

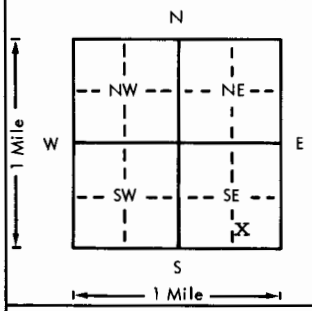

6. Bore hole dia. 9 in. Completion date 7-7-77
Well depth 75 ft.

7. __ Cable tool __ Rotary __ Driven __ Dug
__ Hollow rod __ Jetted __ Bored X Reverse rotary

8. Use: X Domestic __ Public supply __ Industry
__ Irrigation __ Air conditioning __ Stock
__ Lawn __ Oil field water __ Other

9. Casing: Material Styrene Height: Above or below
Threaded ___ Welded X Surface 12 in.
RMP ___ PVC ___ Weight 1.5 lbs./ft.
Dia. 5 in. to 55 ft. depth Wall Thickness: inches or
Dia. ___ in. to ___ ft. depth gage No. 200#

5. Type and color of material	From	To
Top soil	0	5
Clay & limestone streaks	5	60
Water clay & sandstone	60	75
Dakota clay	AT	75
Bedrock		

(Use a second sheet if needed)

10. Screen: Manufacturer's name Jess & Lowell
Type Styrene 200 Dia. 5"
Slot/gauze 1/8 Length 20'
Set between 55 ft. and 75 ft.
___ ft. and ___ ft.
Gravel pack? yes Size range of material 3/8-200

11. Static water level: mo./day/yr.
19'6" ft. below land surface Date 7-7-77

12. Pumping level below land surfaces:
___ ft. after ___ hrs. pumping N/C g.p.m.
___ ft. after ___ hrs. pumping ___ g.p.m.
Estimated maximum yield ___ g.p.m.

13. Water sample submitted: mo./day/yr.
__ Yes X No Date ___

14. Well head completion:
__ Pitless adapter 12 Inches above grade

15. Well grouted? yes
With: X Neat cement ___ Bentonite ___ Concrete
Depth: From 0 ft. to 10 ft.

16. Nearest source of possible contamination: FIELD
ft. ___ Direction ___ Type ___
Well disinfected upon completion? X Yes ___ No

17. Pump: X Not installed
Manufacturer's name ___
Model number ___ HP ___ Volts ___
Length of drop pipe ___ ft. capacity ___ g.p.m.
Type:
__ Submersible __ Turbine
__ Jet __ Reciprocating
__ Centrifugal __ Other

18. Elevation: 1617 Topo
Topography:
__ Hill
__ Slope
__ Upland
__ Valley

19. Remarks:

20. Water well contractor's certification:
This well was drilled under my jurisdiction and this report is true to the best of my knowledge and belief.
Business name Clarke Well & Eq., inc. License No. 185
Address Great Bend, KS 67530
Signed [signature] Date 7-15-77
Authorized representative

T 19 R 8 E/W Sec 29 1/4 SW 1/4 SE 1/4 SE 1/4

Forward the white, blue and pink copies to the Department of Health and Environment

Form WWC-5