


1 LOCATION OF WATER WELL: County: Rice Fraction: SE 1/4 NE 1/4 SW 1/4 Section Number: 33 Township Number: T 19 S Range Number: R 8 EW

Distance and direction from nearest town or city street address of well if located within city? North Logan Street, Lyons, Ks. MW#8

2 WATER WELL OWNER: Rice County Hwy. Dept. RR#, St. Address, Box #: RR#3, Box 32 City, State, ZIP Code: Lyons, Ks. 67554 Board of Agriculture, Division of Water Resources Application Number:

3 LOCATE WELL'S LOCATION WITH AN "X" IN SECTION BOX:

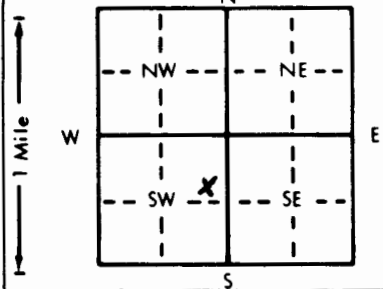

4 DEPTH OF COMPLETED WELL: 40 ft. ELEVATION:

Depth(s) Groundwater Encountered: 1. 32 ft. 2. ft. 3. ft. WELL'S STATIC WATER LEVEL: 32 ft. below land surface measured on mo/day/yr 4-23-91. Pump test data: Well water was ... ft. after ... hours pumping ... gpm. Est. Yield ... gpm: Well water was ... ft. after ... hours pumping ... gpm. Bore Hole Diameter: 7 5/8 in. to 40 ft., and ... in. to ... ft. WELL WATER TO BE USED AS: 5 Public water supply 8 Air conditioning 11 Injection well 1 Domestic 3 Feedlot 6 Oil field water supply 9 Dewatering 12 Other (Specify below) 2 Irrigation 4 Industrial 7 Lawn and garden only 10 Monitoring well. Was a chemical/bacteriological sample submitted to Department? Yes No. If yes, mo/day/yr sample was submitted Water Well Disinfected? Yes No

5 TYPE OF BLANK CASING USED: 1 Steel 3 RMP (SR) 5 Wrought iron 8 Concrete tile CASING JOINTS: Glued Clamped Welded Threaded

Blank casing diameter: 2 in. to 20 in. Dia. Casing height above land surface: 24 in., weight lbs./ft. Wall thickness or gauge No. Sch 40

TYPE OF SCREEN OR PERFORATION MATERIAL: 1 Steel 3 Stainless steel 5 Fiberglass 8 RMP (SR) 10 Asbestos-cement 2 Brass 4 Galvanized steel 6 Concrete tile 9 ABS 12 None used (open hole)

SCREEN OR PERFORATION OPENINGS ARE: 1 Continuous slot 3 Mill slot 5 Gauzed wrapped 8 Saw cut 11 None (open hole) 2 Louvered shutter 4 Key punched 6 Wire wrapped 9 Drilled holes 10 Other (specify)

SCREEN-PERFORATED INTERVALS: From 20 ft. to 40 ft. GRAVEL PACK INTERVALS: From 18 ft. to 40 ft.

6 GROUT MATERIAL: 1 Neat cement 2 Cement grout 3 Bentonite 4 Other

Grout Intervals: From 0 ft. to 18 ft. What is the nearest source of possible contamination: 1 Septic tank 4 Lateral lines 7 Pit privy 11 Fuel storage 14 Abandoned water well 2 Sewer lines 5 Cess pool 8 Sewage lagoon 12 Fertilizer storage 15 Oil well/Gas well 3 Watertight sewer lines 6 Seepage pit 9 Feedyard 13 Insecticide storage 16 Other (specify below)

Direction from well? NE How many feet? 110

Table with 4 columns: FROM, TO, LITHOLOGIC LOG, PLUGGING INTERVALS. Rows show soil layers: Top soil (0-3 ft), Clayey sand (3-12 ft), Silty sand (12-22 ft), Clayey sand (22-40 ft). Plugging interval: Above ground locking cover.

7 CONTRACTOR'S OR LANDOWNER'S CERTIFICATION: This water well was (1) constructed, (2) reconstructed, or (3) plugged under my jurisdiction and was completed on (mo/day/year) 4-23-91 and this record is true to the best of my knowledge and belief. Kansas Water Well Contractor's License No. 527 This Water Well Record was completed on (mo/day/yr) 4-23-91 under the business name of GeoCore Services, Inc. by (signature) Robert Hoplen