

CORRECTION(S) TO WATER WELL RECORD (Form WWC-5)
(to rectify lacking or incorrect information)

LOCATION OF WATER WELL: County: <u>Rice</u>	Fraction <u> </u> $\frac{1}{4}$ <u>NE</u> $\frac{1}{4}$ <u>SE</u> $\frac{1}{4}$ <u>SE</u> $\frac{1}{4}$	Section <u>33</u>	Township T <u>19</u> S	Range R <u>8</u> <input type="checkbox"/> E <input checked="" type="checkbox"/> W
---	---	----------------------	---------------------------	--

Owner: Farmers Coop Union

Location was listed as:

Sec. 33 T 19 S R 8 E W

Fraction: SE SW SE

Location changed to:

Sec. 33 T 19 S R 8 E W

Fraction: NE SE SE

Other changes: Initial statements: _____

Changed to: _____

Comments: Plugging contractor reported (04/16/2014) that this well had been destroyed.

Verification method: Note from plugging contractor, wellsite address, and mapping tool and aerial photos on KGS website.


initials: DRS date: 06/09/2014

Submitted by: Kansas Geological Survey, Data Resources Library, 1930 Constant Ave., Lawrence, KS 66047-3726
to: Kansas Dept of Health & Environment, Bureau of Water, 1000 SW Jackson, Suite 420, Topeka, KS 66612-1367.

1 LOCATION OF WATER WELL: Fraction SE 1/4 SW 1/4 SE 1/4 Section Number 33 Township Number T 19 S Range Number R 8 (EW)

Distance and direction from nearest town or city street address of well if located within city?
In town

2 WATER WELL OWNER: Farmers Coop Union
 RR#, St. Address, Box #: 321 N. Court
 City, State, ZIP Code: Lyons, KS
 Board of Agriculture, Division of Water Resources
 Application Number:

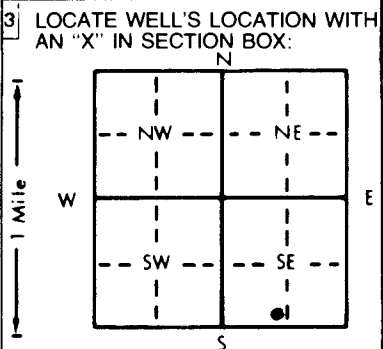

4 DEPTH OF COMPLETED WELL: 45.0 ft. ELEVATION: _____ ft.

Depth(s) Groundwater Encountered 1. 33' ft. 2. _____ ft. 3. _____ ft.

WELL'S STATIC WATER LEVEL 32.9 ft. below land surface measured on mo/day/yr 7-29-92

Pump test data: Well water was _____ ft. after _____ hours pumping _____ gpm

Est. Yield _____ gpm: Well water was _____ ft. after _____ hours pumping _____ gpm

Bore Hole Diameter: 6.58 in. to 45.0 ft., and _____ in. to _____ ft.

WELL WATER TO BE USED AS:

5 Public water supply	8 Air conditioning	11 Injection well
1 Domestic	3 Feedlot	6 Oil field water supply
2 Irrigation	4 Industrial	7 Lawn and garden only
		<u>10 Monitoring well</u>

12 Other (Specify below) _____

Was a chemical/bacteriological sample submitted to Department? Yes _____ No X; If yes, mo/day/yr sample was submitted _____

Water Well Disinfected? Yes _____ No _____

5 TYPE OF BLANK CASING USED:

1 Steel	3 RMP (SR)	5 Wrought iron	8 Concrete tile	CASING JOINTS: Glued _____ Clamped _____
<u>2 PVC</u>	4 ABS	6 Asbestos-Cement	9 Other (specify below)	Welded _____
		7 Fiberglass		Threaded <u>✓</u>

Blank casing diameter 2.38 in. to 24.7 ft., Dia _____ in. to _____ ft., Dia _____ in. to _____ ft.

Casing height above land surface Flush Ground in., weight _____ lbs./ft. Wall thickness or gauge No. SDR-13

TYPE OF SCREEN OR PERFORATION MATERIAL:

1 Steel	3 Stainless steel	5 Fiberglass	8 RMP (SR)	11 Other (specify) _____
2 Brass	4 Galvanized steel	6 Concrete tile	9 ABS	12 None used (open hole)

SCREEN OR PERFORATION OPENINGS ARE:

1 Continuous slot	<u>3 Mill slot</u> <u>.010</u>	5 Gauzed wrapped	8 Saw cut	11 None (open hole)
2 Louvered shutter	4 Key punched	6 Wire wrapped	9 Drilled holes	
		7 Torch cut	10 Other (specify) _____	

SCREEN-PERFORATED INTERVALS: From 44.7 ft. to 24.7 ft., From _____ ft. to _____ ft.

GRAVEL PACK INTERVALS: From 45.0 ft. to 18.5 ft., From _____ ft. to _____ ft.

6 GROUT MATERIAL:

1 Neat cement	<u>2 Cement grout</u>	<u>3 Bentonite</u>	4 Other _____
---------------	-----------------------	--------------------	---------------

Grout Intervals: From 18.5 ft. to 1.6 ft., From 1.6 ft. to 0 ft., From _____ ft. to _____ ft.

What is the nearest source of possible contamination:

1 Septic tank	4 Lateral lines	7 Pit privy	<u>10 Livestock pens</u>	14 Abandoned water well
2 Sewer lines	5 Cess pool	8 Sewage lagoon	<u>11 Fuel storage</u>	15 Oil well/Gas well
3 Watertight sewer lines	6 Seepage pit	9 Feedyard	12 Fertilizer storage	16 Other (specify below) _____
			13 Insecticide storage	

Direction from well? North
 How many feet? 350'

FROM	TO	LITHOLOGIC LOG	FROM	TO	PLUGGING INTERVALS
<u>0.0</u>	<u>0.7</u>	<u>Black silty clay w/bk stained sand & gravel</u>			
<u>0.7</u>	<u>6.0</u>	<u>Mid to Dk Brown silty clay w/ trace rootlets and white black clay specks</u>			
<u>6.0</u>	<u>45.0</u>	<u>Red Brown silty clay w/interbedded black clay stringers w/trace clay nodules and caliche nodules & gravels</u>			

7 CONTRACTOR'S OR LANDOWNER'S CERTIFICATION: This water well was (1 constructed) (2) reconstructed, or (3) plugged under my jurisdiction and was completed on (mo/day/year) 7-29-92 and this record is true to the best of my knowledge and belief. Kansas Water Well Contractor's License No. 539 This Water Well Record was completed on (mo/day/yr) 9-18-92 under the business name of J.B. Env. Drilling by (signature) James Biebu

OFFICE USE ONLY T R SEC. 1/4 1/4 1/4