


MW-10

1 LOCATION OF WATER WELL: County: RICE Fraction: NE 1/4 NE 1/4 SE 1/4 Section Number: 31 Township Number: T 19 S Range Number: R 9 E 10

Distance and direction from nearest town or city street address of well if located within city?

2 WATER WELL OWNER: Pump Mart 417 Main Street Chase, KS 67525 Board of Agriculture, Division of Water Resources Application Number:

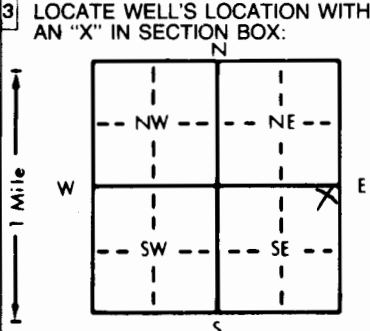

4 DEPTH OF COMPLETED WELL: 30 ft. ELEVATION: —
 Depth(s) Groundwater Encountered 1. 24.5 ft. 2. — ft. 3. — ft.
 WELL'S STATIC WATER LEVEL: 16.84 ft. below land surface measured on 6/16/98
 Pump test data: Well water was — ft. after — hours pumping — gpm
 Est. Yield — gpm Well water was — ft. after — hours pumping — gpm
 Bore Hole Diameter: 8.675 in. to — ft., and — in. to — ft.
 WELL WATER TO BE USED AS: 5 Public water supply 8 Air conditioning 11 Injection well
 1 Domestic 3 Feedlot 6 Oil field water supply 9 Dewatering 12 Other (Specify below)
 2 Irrigation 4 Industrial 7 Lawn and garden only 10 Monitoring well MW-10
 Was a chemical/bacteriological sample submitted to Department? Yes — No X; If yes, mo/day/yr sample was submitted
 Water Well Disinfected? Yes — No X

5 TYPE OF BLANK CASING USED: 1 Steel 3 RMP (SR) 5 Wrought iron 8 Concrete tile CASING JOINTS: Glued — Clamped —
 2 PVC 4 ABS 6 Asbestos-Cement 9 Other (specify below) Welded —
 7 Fiberglass Threaded X
 Blank casing diameter: 2 in. to 20 ft., Dia. — in. to — ft., Dia. — in. to — ft.
 Casing height above land surface: 0 in., weight SCH 40 lbs./ft. Wall thickness or gauge No. —
 TYPE OF SCREEN OR PERFORATION MATERIAL: 1 Steel 3 Stainless steel 5 Fiberglass 8 RMP (SR) 10 Asbestos-cement
 2 Brass 4 Galvanized steel 6 Concrete tile 9 ABS 11 Other (specify) —
 12 None used (open hole)
 SCREEN OR PERFORATION OPENINGS ARE: 5 Gauzed wrapped 8 Saw cut 11 None (open hole)
 1 Continuous slot 2 Mill slot 6 Wire wrapped 9 Drilled holes
 2 Louvered shutter 4 Key punched 7 Torch cut 10 Other (specify) —
 SCREEN-PERFORATED INTERVALS: From — ft. to 30 ft., From — ft. to — ft.
 From — ft. to — ft., From — ft. to — ft.
 GRAVEL PACK INTERVALS: From 19 ft. to 30 ft., From — ft. to — ft.
 From — ft. to — ft., From — ft. to — ft.

6 GROUT MATERIAL: 1 Neat cement 2 Cement grout 3 Bentonite 4 Other —
 Grout Intervals: 0 ft. to 17 ft., From 17 ft. to 19 ft., From — ft. to — ft.
 What is the nearest source of possible contamination: 1 Septic tank 4 Lateral lines 7 Pit privy 10 Livestock pens 14 Abandoned water well
 2 Sewer lines 5 Cess pool 8 Sewage lagoon 11 Fuel storage 15 Oil well/Gas well
 3 Watertight sewer lines 6 Seepage pit 9 Feedyard 12 Fertilizer storage 16 Other (specify below) POSS. CONT. SITE
 13 Insecticide storage

Direction from well? How many feet?

FROM	TO	LITHOLOGIC LOG	FROM	TO	PLUGGING INTERVALS
0	1	SOIL			
1	6	SILT			
6	25	Clayey silt			
25	30	silt and sand			
30	TD	end of Bore hole			

7 CONTRACTOR'S OR LANDOWNER'S CERTIFICATION: This water well was (1) constructed, (2) reconstructed, or (3) plugged under my jurisdiction and was completed on (mo/day/year) 6-2-98 and this record is true to the best of my knowledge and belief. Kansas Water Well Contractor's License No. 585 This Water Well Record was completed on (mo/day/yr) 6/17/98 under the business name of A&I by (signature) Atkinson or Bracht

OFFICE USE ONLY

T

R

EW

SEC

1/4

1/4

1/4