


1 LOCATION OF WATER WELL: Fraction C 1/4 SE 1/4 SE 1/4 Section Number 19 Township Number T 19 S Range Number R 9 E 9

County: Rice Stafford Distance and direction from nearest town or city street address of well if located within city? 1 1/2 north of Chase

2 WATER WELL OWNER: Charles Rolf Meltzer Oil Co.  
 RR#, St. Address, Box #: Bushton, Ks. 11801 Tatum Blvd.  
 City, State, ZIP Code: Phoenix, Arizona 85028 Board of Agriculture, Division of Water Resources Application Number: T84-164

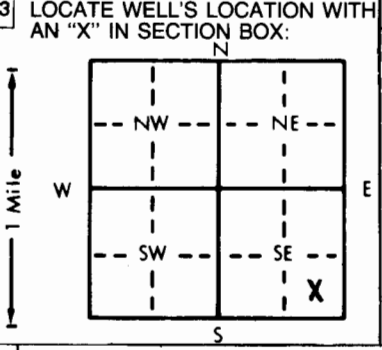

4 DEPTH OF COMPLETED WELL: 85 ft. ELEVATION: ...  
 Depth(s) Groundwater Encountered 1... 2.1 ft. 2... ft. 3... ft.  
 WELL'S STATIC WATER LEVEL ... 2.1 ft. below land surface measured on mo/day/yr ... 3-22-84  
 Pump test data: Well water was ... ft. after ... hours pumping ... gpm  
 Est. Yield ... NA ... gpm: Well water was ... ft. after ... hours pumping ... gpm  
 Bore Hole Diameter ... 10 in. to ... 8.5 ft., and ... in. to ... ft.  
 WELL WATER TO BE USED AS:  
 5 Public water supply 8 Air conditioning 11 Injection well  
 1 Domestic 3 Feedlot 6 Oil field water supply 9 Dewatering 12 Other (Specify below)  
 2 Irrigation 4 Industrial 7 Lawn and garden only 10 Observation well  
 Was a chemical/bacteriological sample submitted to Department? Yes... No... X...; If yes, mo/day/yr sample was submitted  
 Water Well Disinfected? Yes HTH No

5 TYPE OF BLANK CASING USED:  
 1 Steel 3 RMP (SR) 5 Wrought iron 8 Concrete tile CASING JOINTS: Glued X Clamped  
 2 PVC 4 ABS 6 Asbestos-Cement 9 Other (specify below) Welded  
 7 Fiberglass Threaded  
 Blank casing diameter ... 5 in. to ... 6.5 ft., Dia ... in. to ... ft., Dia ... in. to ... ft.  
 Casing height above land surface ... 1.8 in., weight ... lbs./ft. Wall thickness or gauge No. ... 258

TYPE OF SCREEN OR PERFORATION MATERIAL:  
 1 Steel 3 Stainless steel 5 Fiberglass 7 PVC 10 Asbestos-cement  
 2 Brass 4 Galvanized steel 6 Concrete tile 8 RMP (SR) 11 Other (specify)  
 9 ABS 12 None used (open hole)  
 SCREEN OR PERFORATION OPENINGS ARE:  
 1 Continuous slot 3 Mill slot 5 Gauzed wrapped 8 Saw cut 11 None (open hole)  
 2 Louvered shutter 4 Key punched 6 Wire wrapped 9 Drilled holes  
 7 Torch cut 10 Other (specify)  
 SCREEN-PERFORATED INTERVALS: From ... 6.5 ft. to ... 8.5 ft., From ... ft. to ... ft.  
 GRAVEL PACK INTERVALS: From ... 10 ft. to ... 8.5 ft., From ... ft. to ... ft.

6 GROUT MATERIAL: 1 Neat cement 2 Cement grout 3 Bentonite 4 Other  
 Grout Intervals: From ... 0 ft. to ... 10 ft., From ... ft. to ... ft., From ... ft. to ... ft.  
 What is the nearest source of possible contamination:  
 1 Septic tank 4 Lateral lines 7 Pit privy 10 Livestock pens 14 Abandoned water well  
 2 Sewer lines 5 Cess pool 8 Sewage lagoon 11 Fuel storage 15 Oil well/Gas well  
 3 Watertight sewer lines 6 Seepage pit 9 Feedyard 12 Fertilizer storage 16 Other (specify below)  
 13 Insecticide storage  
 Direction from well? west How many feet? 100

FROM	TO	LITHOLOGIC LOG	FROM	TO	LITHOLOGIC LOG
0	5	Dark top soil			
5	60	Tan sandy clay w/streaks of fine sand			
60	68	Medium sand			
68	85	Tan sandy clay			

7 CONTRACTOR'S OR LANDOWNER'S CERTIFICATION: This water well was (1) constructed, (2) reconstructed, or (3) plugged under my jurisdiction and was completed on (mo/day/year) ... 3-22-84 ... and this record is true to the best of my knowledge and belief. Kansas Water Well Contractor's License No. ... 134 ... This Water Well Record was completed on (mo/day/yr) ... 5-1-84 ... under the business name of Rosencrantz-Bemis Ent. by (signature) Ron Dodson

INSTRUCTIONS: Use typewriter or ball point pen, PLEASE PRESS FIRMLY and PRINT clearly. Please fill in blanks, underline or circle the correct answers. Send top three copies to Kansas Department of Health and Environment, Division of Environment, Environmental Geology Section, Topeka, KS 66620. Send one to WATER WELL OWNER and retain one for your records.