


**WATER WELL RECORD Form WWC-5 KSA 82a-1212**

1] LOCATION OF WATER WELL: County: <u>Rice</u>	Fraction <u>NW</u> ¼ <u>SW</u> ¼ <u>NW</u> ¼	Section Number <u>23</u>	Township Number T <u>19</u> S	Range Number R <u>9W</u> E/W
---	---	-----------------------------	----------------------------------	---------------------------------

Distance and direction from nearest town or city street address of well if located within city?  
3 N, 3 1/4 E of Chase, Kansas

2] WATER WELL OWNER: RR#, St. Address, Box # : City, State, ZIP Code :	<u>White &amp; Ellis Drilling, Inc.</u> <u>401 E Douglas, Suite 500</u> <u>Wichita, Kansas 67202</u>	Board of Agriculture, Division of Water Resources Application Number: <u>Unknown</u>
--	--	---

3] LOCATE WELL'S LOCATION WITH AN "X" IN SECTION BOX:

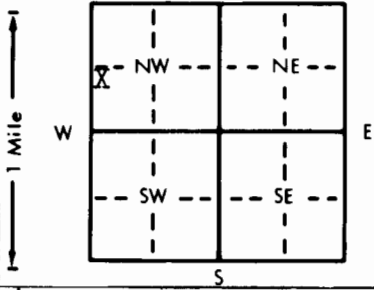

4] DEPTH OF COMPLETED WELL <u>113</u> ft. ELEVATION: <u>Unknown</u>	Depth(s) Groundwater Encountered 1. <u>57</u> ft. 2. <u>57</u> ft. 3. <u>2/26/82</u> ft.	WELL'S STATIC WATER LEVEL <u>57</u> ft. below land surface measured on mo/day/yr
Pump test data: Well water was _____ ft. after _____ hours pumping _____ gpm		
Est. Yield <u>60</u> gpm: Well water was _____ ft. after _____ hours pumping _____ gpm		
Bore Hole Diameter <u>8</u> in. to <u>113</u> ft., and _____ in. to _____ ft.		
WELL WATER TO BE USED AS:		
5 Public water supply	8 Air conditioning	11 Injection well
1 Domestic	3 Feedlot	6 <u>Oil field water supply</u>
2 Irrigation	4 Industrial	7 Lawn and garden only
9 Dewatering	10 Observation well	12 Other (Specify below)
Was a chemical/bacteriological sample submitted to Department? Yes <u>No</u> ; If yes, mo/day/yr sample was submitted _____		
Water Well Disinfected? Yes <u>No</u>		

5] TYPE OF BLANK CASING USED:	5 Wrought iron	8 Concrete tile	CASING JOINTS: <u>Glued</u> Clamped _____
1 Steel	3 RMP (SR)	6 Asbestos-Cement	9 Other (specify below)
2 <u>PVC</u>	4 ABS	7 Fiberglass	_____ Welded _____
Blank casing diameter <u>5</u> in. to <u>93</u> ft., Dia _____ in. to _____ ft., Dia _____ in. to _____ ft.			
Casing height above land surface <u>12</u> in., weight <u>2.8</u> lbs./ft. Wall thickness or gauge No. <u>Sch. 40</u>			
TYPE OF SCREEN OR PERFORATION MATERIAL:			
1 Steel	3 Stainless steel	5 Fiberglass	7 <u>PVC</u>
2 Brass	4 Galvanized steel	6 Concrete tile	8 RMP (SR)
SCREEN OR PERFORATION OPENINGS ARE:			
1 Continuous slot	3 Mill slot	5 Gauzed wrapped	8 <u>Saw cut</u>
2 Louvered shutter	4 Key punched	6 Wire wrapped	9 Drilled holes
SCREEN-PERFORATED INTERVALS: From <u>93</u> ft. to <u>113</u> ft., From _____ ft. to _____ ft.			
GRAVEL PACK INTERVALS: From <u>10</u> ft. to <u>113</u> ft., From _____ ft. to _____ ft.			

6] GROUT MATERIAL: <u>1 Neat cement</u>	2 Cement grout	3 Bentonite	4 Other _____
Grout intervals: From <u>0</u> ft. to <u>10</u> ft., From _____ ft. to _____ ft., From _____ ft. to _____ ft.			
What is the nearest source of possible contamination:			
1 Septic tank	4 Lateral lines	7 Pit privy	10 Livestock pens
2 Sewer lines	5 Cess pool	8 Sewage lagoon	11 Fuel storage
3 Watertight sewer lines	6 Seepage pit	9 Feedyard	12 Fertilizer storage
Direction from well? <u>East</u> How many feet? <u>60</u>			

FROM	TO	LITHOLOGIC LOG	FROM	TO	LITHOLOGIC LOG
0	50	Clay			
50	113	Sand rock			

7] CONTRACTOR'S OR LANDOWNER'S CERTIFICATION: This water well was (1) constructed, (2) reconstructed, or (3) plugged under my jurisdiction and was completed on (mo/day/year) 2/26/82 and this record is true to the best of my knowledge and belief. Kansas Water Well Contractor's License No. 186 This Water Well Record was completed on (mo/day/yr) 3/22/82 under the business name of Kellys Water Well Service by (signature) Deoxy Dood

INSTRUCTIONS: Use typewriter or ball point pen, **PLEASE PRESS FIRMLY** and **PRINT** clearly. Please fill in blanks, underline or circle the correct answers. Send top three copies to Kansas Department of Health and Environment, Division of Environment, Environmental Geology Section, Topeka, KS 66620. Send one to WATER WELL OWNER and retain one for your records.

OFFICE USE ONLY  
T 19  
R  
SEC 23  
NW 1/4 SW 1/4