


1 LOCATION OF WATER WELL: Fraction Section Number Township Number Range Number  
 County: Rice 080 NE 1/4 SE 1/4 NE 1/4 30 T 19 S R 9 EW

Distance and direction from nearest town or city street address of well if located within city?  
 Approx. 1 mile north of Chase, KS

2 WATER WELL OWNER: Robert Link  
 RR#, St. Address, Box #: Route 1 Board of Agriculture, Division of Water Resources  
 City, State, ZIP Code: Chase, KS 67524 Application Number: not required

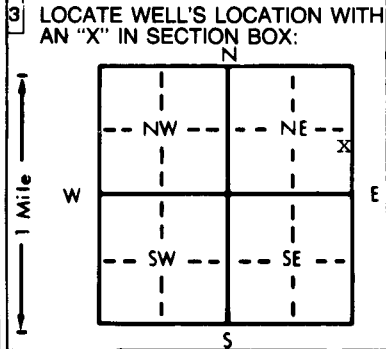

4 DEPTH OF COMPLETED WELL: 59 ft. ELEVATION: unknown  
 Depth(s) Groundwater Encountered 1. 24 ft. 2. ft. 3. ft.  
 WELL'S STATIC WATER LEVEL: 24 ft. below land surface measured on mo/day/yr 4/16/88  
 Pump test data: Well water was not ck'd. ft. after hours pumping gpm  
 Est. Yield unknown gpm: Well water was ft. after hours pumping gpm  
 Bore Hole Diameter: 9 in. to 5.7 ft., and in. to ft.  
 WELL WATER TO BE USED AS:  
 1 Domestic 3 Feedlot 6 Oil field water supply 9 Dewatering 11 Injection well  
 2 Irrigation 4 Industrial 7 Lawn and garden only 10 Observation well  
 Was a chemical/bacteriological sample submitted to Department? Yes No X; If yes, mo/day/yr sample was submitted  
 Water Well Disinfected? Yes X No

5 TYPE OF BLANK CASING USED:  
 1 Steel 3 RMP (SR) 5 Wrought iron 8 Concrete tile CASING JOINTS: Glued X Clamped  
 2 PVC 4 ABS 6 Asbestos-Cement 9 Other (specify below) Welded  
 7 Fiberglass Threaded  
 Blank casing diameter 5 in. to 4.2 ft., Dia in. to ft., Dia in. to ft.  
 Casing height above land surface 24 in., weight 2.277 lbs./ft. Wall thickness or gauge No. 214  
 TYPE OF SCREEN OR PERFORATION MATERIAL:  
 1 Steel 3 Stainless steel 5 Fiberglass 8 RMP (SR) 10 Asbestos-cement  
 2 Brass 4 Galvanized steel 6 Concrete tile 9 ABS 11 Other (specify)  
 12 None used (open hole)  
 SCREEN OR PERFORATION OPENINGS ARE:  
 1 Continuous slot 3 Mill slot 5 Gauzed wrapped 8 Saw cut 11 None (open hole)  
 2 Louvered shutter 4 Key punched 6 Wire wrapped 9 Drilled holes  
 7 Torch cut 10 Other (specify)  
 SCREEN-PERFORATED INTERVALS: From 42 ft. to 57 ft., From ft. to ft.  
 From ft. to ft., From ft. to ft.  
 GRAVEL PACK INTERVALS: From 30 ft. to 57 ft., From ft. to ft.  
 Annular Fill From 20 ft. to 30 ft., From ft. to ft.

6 GROUT MATERIAL: 1 Neat cement 2 Cement grout 3 Bentonite 4 Other  
 Grout intervals: From 0 ft. to 20 ft., From ft. to ft., From ft. to ft.  
 What is the nearest source of possible contamination:  
 1 Septic tank 4 Lateral lines 7 Pit privy 10 Livestock pens 14 Abandoned water well  
 2 Sewer lines 5 Cess pool 8 Sewage lagoon 11 Fuel storage 15 Oil well/Gas well  
 3 Watertight sewer lines 6 Seepage pit 9 Feedyard 12 Fertilizer storage 16 Other (specify below)  
 13 Insecticide storage PASTURE LAND.  
 Direction from well? all How many feet?

FROM	TO	LITHOLOGIC LOG	FROM	TO	LITHOLOGIC LOG
0	30 <u>01</u>	Topsoil & clay, brown & green			
30	38 <u>07</u>	Fine sand			
38	41 <u>01</u>	Clay, brown			
41	57 <u>17</u>	Sand & gravel, medium to fine			

7 CONTRACTOR'S OR LANDOWNER'S CERTIFICATION: This water well was (1) constructed, (2) reconstructed, or (3) plugged under my jurisdiction and was completed on (mo/day/year) 4/16/88 and this record is true to the best of my knowledge and belief. Kansas Water Well Contractor's License No. 185 This Water Well Record was completed on (mo/day/yr) 4/19/88 under the business name of Clarke Well & Equipment, Inc. by (signature)

INSTRUCTIONS: Use typewriter or ball point pen. PLEASE PRESS FIRMLY and PRINT clearly. Please fill in blanks, underline or circle the correct answers. Send top three copies to Kansas Department of Health and Environment, Bureau of Water Protection, Topeka, Kansas 66620-7320, Telephone: 913-862-9360. Send one to WATER WELL OWNER and retain one for your records.

OFFICE USE ONLY  
T  
19  
R  
9  
EW  
SEC.  
30  
NE 1/4 SE 1/4 NE 1/4