CORRECTION(S) TO WATER WELL RECORD (WWC-5)
(to rectify lacking or incorrect information)

County: Phillips

Location listed as:	**Location changed to:**
Section-Township-Range: 31-1-20	31-15-20W
Fraction (¼ ¼ ¼): SW	W2 SE SW

Other changes: Initial statements: _____

Changed to: _____

Comments: _____

verification method: Legal description, position on plat map, and mapping tool & aerial photos on KGS website.

initials: DRL date: 11/19/2009

submitted by: Kansas Geological Survey, Data Resources Library, 1930 Constant Ave., Lawrence, KS 66047-3726
to: Kansas Dept of Health & Environment, Bureau of Water, 1000 SW Jackson, Suite 420, Topeka, KS 66612-1367.

WATER WELL PLUGGING RECORD Form WWC-5P KSA 82a-1212 ID NO. _____

1 LOCATION OF WATER WELL:	Fraction	Section Number	Township Number	Range Number
County: Phillips	¼ ¼ SW ¼	31	1	20

Distance and direction from nearest town or city street address of well if located within city? 3 3/4 SW of Long Island

2 WATER WELL OWNER: Carol Ross

RR #, St. Address, Box #: Rural Route 1 Box 20
City, State, ZIP Code : Almena, Kansas 67622-9714

Board of Agriculture, Division of Water Resources
Application Number:

3 MARK WELL'S LOCATION WITH AN "X" IN SECTION BOX:

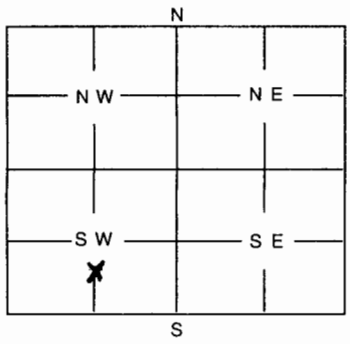

4 DEPTH OF WELL 80' ft

WELL'S STATIC WATER LEVEL 29' ft.

WELL WAS USED AS:

1 Domestic	5 Public Water Supply	9 Dewatering
(2) Irrigation	6 Oil Field Water Supply	10 Monitoring Well
3 Feedlot	7 Domestic (Lawn & Garden)	11 Injection Well
4 Industrial	8 Air Conditioning	12 Other

Was a chemical / bacteriological sample submitted to Department? Yes ..... No X
If yes, mo/day/yr sample was submitted .....

Water Well Disinfected: Yes X No .....

5 TYPE OF BLANK CASING USED:

(1) Steel	3 RMP (SR)	5 Wrought	7 Fiberglass	9 Other (Specify below)	
2 PVC	4 ABS	6 Asbestos-Cement	8 Concrete Tile		

Blank casing diameter 16 in. Was casing pulled? Yes ..... No X If yes, how much .....
Casing height above or below land surface 8" in.

6 GROUT PLUG MATERIAL: 1 Neat cement 2 Cement grout (3) Bentonite 4 Other .....

Grout Plug Intervals: From 0 ft. to 32' ft., From ..... ft. to ..... ft., From ..... to ..... ft.

What is the nearest source of possible contamination:

1 Septic tank	6 Seepage pit	11 Fuel storage	16 Other (specify below) Active well
2 Sewer lines	7 Pit privy	12 Fertilizer storage	
3 Watertight sewer lines	8 Sewage lagoon	13 Insecticide storage	
4 Lateral lines	9 Feedyard	14 Abandoned water well	
5 Cess Pool	10 Livestock pens	15 Oil well/Gas well	

Direction from well? Std How many feet? 10

FROM	TO	PLUGGING MATERIALS
0	32	Bentonite Chunks
32	80	Chlorinated gravel
Top	6"	Concrete

7 CONTRACTOR'S OR LANDOWNER'S CERTIFICATION: This water well was plugged under my jurisdiction and was completed on (mo/day/year) 8/6/2008 and this record is true to the best of my knowledge and belief. Kansas Water Well Contractor's License No. 433 This Water Well Record was completed on (mo/day/year) 8/6/2008 under the business name of Chas. Sargent Irrigation Co., Inc. by (signature) .....

INSTRUCTIONS: Use typewriter or ball point pen. Please press firmly and print clearly. Please fill in blanks, underline or circle the correct answers. Send top three copies to Kansas Department of Health and Environment, Bureau of Water, Topeka, Kansas 66620-0001. Telephone: 785/296-3565. Send one to Water Well Owner and retain one for your records.