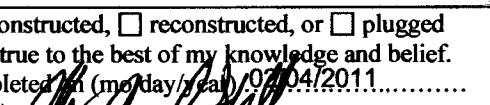


WATER WELL RECORD

Form WWC-5

Division of Water Resources App. No.

1 LOCATION OF WATER WELL: County: Phillips		Fraction SE ¼ NE ¼ SE ¼ SE ¼	Section Number 29	Township No. T 1 S	Range Number R 20 <input type="checkbox"/> E <input checked="" type="checkbox"/> W	
Street/Rural Address of Well Location; if unknown, distance & direction from nearest town or intersection: If at owner's address, check here <input type="checkbox"/>			Global Positioning System (GPS) information: Latitude: 39.9315830 (in decimal degrees) Longitude: -99.5903330 (in decimal degrees) Elevation: Datum: <input type="checkbox"/> WGS 84, <input type="checkbox"/> NAD 83, <input type="checkbox"/> NAD 27	
2 WATER WELL OWNER: Cox's Valley View Farms RR#, Street Address, Box #: 491 W 1400 Road City, State, ZIP Code : Long Island, KS 67647			Collection Method: <input checked="" type="checkbox"/> GPS unit (Make/Model: Handheld) <input type="checkbox"/> Digital Map/Photo, <input type="checkbox"/> Topographic Map, <input type="checkbox"/> Land Survey Est. Accuracy: <input type="checkbox"/> <3 m, <input type="checkbox"/> 3-5 m, <input type="checkbox"/> 5-15 m, <input type="checkbox"/> >15 m	
3 LOCATE WELL WITH AN "X" IN SECTION BOX: NW NE SW SE N E S -----1 mile-----		4 DEPTH OF COMPLETED WELL 60' ft. Depth(s) Groundwater Encountered (1) ft. (2) ft. (3) ft. WELL'S STATIC WATER LEVEL 24' ft. below land surface measured on mo/day/yr. Pump test data: Well water was 30 ft. after 1 hours pumping. 200 gpm EST. YIELD 25 gpm. Well water was 41 ft. after 1 hours pumping. 400 gpm Bore Hole Diameter 28 in. to 60 ft., and in. to ft. WELL WATER TO BE USED AS: <input type="checkbox"/> Public water supply <input type="checkbox"/> Geothermal <input type="checkbox"/> Injection well <input type="checkbox"/> Domestic <input type="checkbox"/> Feedlot <input type="checkbox"/> Oil field water supply <input type="checkbox"/> Dewatering <input type="checkbox"/> Other (Specify below) <input checked="" type="checkbox"/> Irrigation <input type="checkbox"/> Industrial <input type="checkbox"/> Domestic-lawn & garden <input type="checkbox"/> Monitoring well Was a chemical/bacteriological sample submitted to Department? <input type="checkbox"/> Yes <input checked="" type="checkbox"/> No If yes, mo/day/yr sample was submitted Water well disinfected? <input type="checkbox"/> Yes <input checked="" type="checkbox"/> No	
5 TYPE OF CASING USED: <input type="checkbox"/> Steel <input checked="" type="checkbox"/> PVC <input type="checkbox"/> Other CASING JOINTS: <input checked="" type="checkbox"/> Glued <input type="checkbox"/> Clamped <input type="checkbox"/> Welded <input type="checkbox"/> Threaded Casing diameter 16 in. to 33 ft., Diameter in. to ft., Diameter in. to ft. Casing height above land surface 18 in., Weight lbs./ft., Wall thickness or gauge No. SDR 26 TYPE OF SCREEN OR PERFORATION MATERIAL: <table style="width: 100%; border-collapse: collapse;"> <tr> <td style="width: 25%;"><input type="checkbox"/> Steel</td> <td style="width: 25%;"><input type="checkbox"/> Stainless Steel</td> <td style="width: 25%;"><input checked="" type="checkbox"/> PVC</td> <td style="width: 25%;"><input type="checkbox"/> Other (Specify)</td> </tr> <tr> <td><input type="checkbox"/> Brass</td> <td><input type="checkbox"/> Galvanized Steel</td> <td><input type="checkbox"/> None used (open hole)</td> <td></td> </tr> </table> SCREEN OR PERFORATION OPENINGS ARE: <table style="width: 100%; border-collapse: collapse;"> <tr> <td style="width: 25%;"><input checked="" type="checkbox"/> Continuous slot</td> <td style="width: 25%;"><input type="checkbox"/> Mill slot</td> <td style="width: 25%;"><input type="checkbox"/> Gauze wrapped</td> <td style="width: 25%;"><input type="checkbox"/> Torch cut</td> <td style="width: 25%;"><input type="checkbox"/> Drilled holes</td> <td style="width: 25%;"><input type="checkbox"/> None (open hole)</td> </tr> <tr> <td><input type="checkbox"/> Louvered shutter</td> <td><input type="checkbox"/> Key punched</td> <td><input type="checkbox"/> Wire wrapped</td> <td><input type="checkbox"/> Saw cut</td> <td><input type="checkbox"/> Other (specify)</td> <td></td> </tr> </table> SCREEN-PERFORATED INTERVALS: From 33 ft. to 60 ft., From ft. to ft. to ft. From ft. to ft., From ft. to ft. GRAVEL PACK INTERVALS: From 20 ft. to 30 ft., From ft. to ft. From 33 ft. to 60 ft.
6 GROUT MATERIAL: <input type="checkbox"/> Neat cement <input type="checkbox"/> Cement grout <input checked="" type="checkbox"/> Bentonite <input type="checkbox"/> Other Grout Intervals: From 0 ft. to 20 ft., From 30 ft. to 33 ft., From ft. to ft. What is the nearest source of possible contamination: <table style="width: 100%; border-collapse: collapse;"> <tr> <td style="width: 25%;"><input type="checkbox"/> Septic tank</td> <td style="width: 25%;"><input type="checkbox"/> Lateral lines</td> <td style="width: 25%;"><input type="checkbox"/> Pit privy</td> <td style="width: 25%;"><input type="checkbox"/> Livestock pens</td> <td style="width: 25%;"><input type="checkbox"/> Insecticide storage</td> <td style="width: 25%;"><input type="checkbox"/> Other (specify below)</td> </tr> <tr> <td><input type="checkbox"/> Sewer lines</td> <td><input type="checkbox"/> Cesspool</td> <td><input type="checkbox"/> Sewage lagoon</td> <td><input type="checkbox"/> Fuel storage</td> <td><input checked="" type="checkbox"/> Abandoned water well</td> <td></td> </tr> <tr> <td><input type="checkbox"/> Watertight sewer lines</td> <td><input type="checkbox"/> Seepage pit</td> <td><input type="checkbox"/> Feedyard</td> <td><input type="checkbox"/> Fertilizer storage</td> <td><input type="checkbox"/> Oil well/gas well</td> <td></td> </tr> </table> Direction from well 20 ft Distance from well Southeast <table border="1" style="width: 100%; border-collapse: collapse;"> <thead> <tr> <th style="width: 25%;">FROM</th> <th style="width: 25%;">TO</th> <th style="width: 50%;">LITHOLOGIC LOG</th> <th style="width: 25%;">FROM</th> <th style="width: 25%;">TO</th> <th style="width: 50%;">LITHO. LOG (cont.) or PLUGGING INTERVALS</th> </tr> </thead> <tbody> <tr><td>0</td><td>4</td><td>Top soil</td><td></td><td></td><td></td></tr> <tr><td>4</td><td>20</td><td>Clay with thin soft sandstone strip</td><td></td><td></td><td></td></tr> <tr><td>20</td><td>40</td><td>Clay w/ traces fine sand & s.stone</td><td></td><td></td><td></td></tr> <tr><td>40</td><td>50</td><td>Coarse sand to fine gravel with thin clay layers</td><td></td><td></td><td></td></tr> <tr><td>50</td><td>51</td><td>Limestone</td><td></td><td></td><td></td></tr> <tr><td>51</td><td>56</td><td>Fine to medium gravel with thin limestone and flint layers</td><td></td><td></td><td></td></tr> <tr><td>57</td><td>60</td><td>Shale</td><td></td><td></td><td></td></tr>
7 CONTRACTOR'S OR LANDOWNER'S CERTIFICATION: This water well was <input checked="" type="checkbox"/> constructed, <input type="checkbox"/> reconstructed, or <input type="checkbox"/> plugged under my jurisdiction and was completed on (mo/day/year) 01/06/2011 and this record is true to the best of my knowledge and belief. Kansas Water Well Contractor's License No. 433 This Water Well Record was completed on (mo/day/year) 02/04/2011 under the business name of .. Sargent Irrigation by (signature) 	
INSTRUCTIONS: Use typewriter or ball point pen. PLEASE PRESS FIRMLY and PRINT clearly. Please fill in blanks and check the correct answers. Send three copies (white, blue, pink) to Kansas Department of Health and Environment, Bureau of Water, Geology Section, 1000 SW Jackson St., Suite 420, Topeka, Kansas 66612-1367. Telephone 785-296-5522. Send one copy to WATER WELL OWNER and retain one for your records. Include fee of \$5.00 for each <u>constructed</u> well. Visit us at http://www.kdheks.gov/waterwell/index.html .	