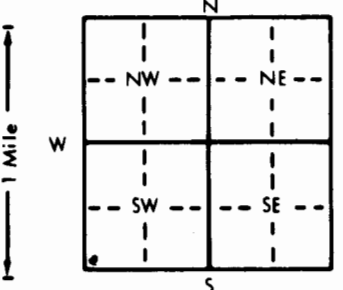


1 LOCATION OF WATER WELL: County: <u>Norton</u>	Fraction <u>SW 1/4 SW 1/4 SW 1/4</u>	Section Number <u>22</u>	Township Number <u>T 1 S</u>	Range Number <u>R 24 E/W</u>
--	---	-----------------------------	---------------------------------	---------------------------------

Distance and direction from nearest town or city street address of well if located within city?
From Norton, Ks Junction 36+283 - 7 mi W + 7 mi N

2 WATER WELL OWNER: <u>Darrell Walker</u>	Board of Agriculture, Division of Water Resources
RR#, St. Address, Box # <u>PO Box 402</u>	Application Number:
City, State, ZIP Code: <u>Peru, Illinois 61354</u>	

3 LOCATE WELL'S LOCATION WITH AN "X" IN SECTION BOX: 	4 DEPTH OF COMPLETED WELL: <u>112</u> ft. ELEVATION: Depth(s) Groundwater Encountered 1. ft. 2. ft. 3. ft. WELL'S STATIC WATER LEVEL: <u>89</u> ft. below land surface measured on mo/day/yr Pump test data: Well water was ft. after hours pumping gpm Est. Yield gpm: Well water was ft. after hours pumping gpm Bore Hole Diameter: <u>9 1/2</u> in. to <u>11 1/2</u> in. to in. to in. WELL WATER TO BE USED AS: <u>1 Domestic</u> 3 Feedlot 6 Oil field water supply 9 Dewatering 12 Other (Specify below) 2 Irrigation 4 Industrial 7 Lawn and garden only 10 Monitoring well Was a chemical/bacteriological sample submitted to Department? Yes No ; If yes, mo/day/yr sample was submitted Water Well Disinfected? Yes <input checked="" type="checkbox"/> No
--	---

5 TYPE OF BLANK CASING USED: 1 Steel 3 RMP (SR) <u>2 PVC</u> 4 ABS Blank casing diameter <u>5</u> in. to <u>9 1/2</u> ft., Dia in. to ft., Dia in. to ft. Casing height above land surface <u>12</u> in., weight lbs./ft. Wall thickness or gauge No. <u>SDR 21</u> TYPE OF SCREEN OR PERFORATION MATERIAL: 1 Steel 3 Stainless steel 5 Fiberglass 8 RMP (SR) 2 Brass 4 Galvanized steel 6 Concrete tile 9 ABS SCREEN OR PERFORATION OPENINGS ARE: 1 Continuous slot 3 Mill slot 6 Wire wrapped 9 Drilled holes 2 Louvered shutter 4 Key punched 7 Torch cut 10 Other (specify) SCREEN-PERFORATED INTERVALS: From <u>92</u> ft. to <u>112</u> ft., From ft. to ft. GRAVEL PACK INTERVALS: From <u>25</u> ft. to <u>112</u> ft., From ft. to ft.	5 Wrought iron 8 Concrete tile CASING JOINTS: Glued <input checked="" type="checkbox"/> Clamped 6 Asbestos-Cement 9 Other (specify below) Welded 7 Fiberglass Threaded 8 Saw cut 11 None (open hole) 10 Asbestos-cement 11 Other (specify) 12 None used (open hole)
--	---

6 GROUT MATERIAL: 1 Neat cement 2 Cement grout 3 <u>Bentonite</u> 4 Other	Grout intervals: From <u>5</u> ft. to <u>25</u> ft., From ft. to ft.
What is the nearest source of possible contamination: 1 Septic tank 4 Lateral lines 7 Pit privy 10 Livestock pens 14 Abandoned water well 2 Sewer lines 5 Cess pool 8 Sewage lagoon 11 Fuel storage 15 Oil well/Gas well 3 Watertight sewer lines 6 Seepage pit 9 Feedyard 12 Fertilizer storage 16 Other (specify below) 13 Insecticide storage	Direction from well? How many feet? <u>nothing</u>

FROM	TO	LITHOLOGIC LOG	FROM	TO	PLUGGING INTERVALS
0	32	Top Soil/clay			
32	56	Sandy clay + sandstone			
56	58	Hard Sandstone			
58	112	Sandy clay, sandstone + Pmsand			

7 CONTRACTOR'S OR LANDOWNER'S CERTIFICATION: This water well was (1) constructed, (2) reconstructed, or (3) plugged under my jurisdiction and was completed on (mo/day/year) <u>6-11-03</u> and this record is true to the best of my knowledge and belief. Kansas Water Well Contractor's License No. <u>428</u> This Water Well Record was completed on (mo/day/year) <u>6-26-03</u> under the business name of <u>STALDER DRILLING</u> by (signature) <u>Jerry L. Stalder</u>
--

OFFICE USE ONLY
T
R
EM
SEC.
1/4
1/4
1/4