

County: Republic Fraction: SE, NE, NE, NE Sec. 2 T. 1 S R. 3 E/W

CORRECTION(S) to WATER WELL COMPLETION RECORD Form WWC-5 (to rectify lacking or incorrect information)

Owner: C & M Supply Inc

If location corrected, was listed as:

Section-Township-Range: 2-1-3

Fraction (1/4 calls): NE

Location changed to:

2-1-3 W

SE, NE, NE, NE

Other changes: Initial statements: _____

100 yds SE of C&M Supply Bldg

Changed to: 100 yds S of C&M Supply Bldg

Comments: _____

Verification method: Telephone conversation w/owner and Google Earth air photos.

Initials: PKC Date: 3/30/16

Submitted by: Kansas Geological Survey, Data Resources Library, 1930 Constant Ave., Lawrence, KS 66047-3726

Kansas Dept. of Health & Environment, Bureau of Water, 1000 SW Jackson, Suite 420, Topeka, KS 66612-1367


1 LOCATION OF WATER WELL: Fraction NE 1/4 1/4 1/4 Section Number 2 Township Number 1 Range Number 3 E/W

Distance and direction from nearest town or city street address of well if located within city?

100 yds Southeast of C & M Supply building

2 WATER WELL OWNER: C & M Supply Inc. **Global Positioning Systems** (decimal degrees, min. of 4 digits)
 RR#, St. Address, Box #: PO Box 8 Latitude: _____
 City, State ZIP Code: Ruskin NE 68974 Longitude: _____
 Elevation: _____
 Datum: _____
 Data Collection Method: _____

3 MARK WELL'S LOCATION WITH AN "X" IN SECTION BOX:

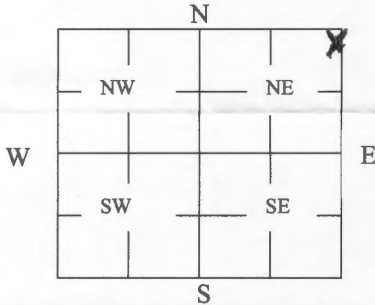

4 DEPTH OF WELL 170 ft.

WELL'S STATIC WATER LEVEL 28 ft

WELL WAS USED AS:

- | | | |
|--------------|-----------------------------------------------------------|-------------------|
| 1 Domestic | <input checked="" type="checkbox"/> 3 Public Water Supply | 9 Dewatering |
| 2 Irrigation | 6 Oil Field Water Supply | 10 Monitoring |
| 3 Feedlot | 7 Domestic (Lawn & Garden) | 11 Injection Well |
| 4 Industrial | 8 Air Conditioning | 12 Other _____ |

Was a chemical/bacteriological sample submitted to Department? Yes _____ No

5 TYPE OF BLANK CASING USED:

- | | | | | |
|---------------------------------------------|------------|-------------------|-----------------|-------------------------|
| <input checked="" type="checkbox"/> 1 Steel | 3 RMP (SR) | 5 Wrought | 7 Fiberglass | 9 Other (Specify below) |
| 2 PVC | 4 ABS | 6 Asbestos-Cement | 8 Concrete Tile | _____ |

Blank casing diameter 6 in. Was casing pulled? Yes _____ No If yes, how much _____
 Casing height above or below land surface 3 1/2 ft.

6 GROUT PLUG MATERIAL: 1 Neat cement 2 Cement grout 3 Bentonite 4 Other _____

Grout Plug Intervals: From 3 1/2 ft. to 7 ft., From _____ ft. to _____ ft., From _____ to _____ ft.

What is the nearest source of possible contamination:

- | | | | |
|--------------------------|-------------------|-----------------------------------------------------|-----------------------------------|
| 1 Septic tank | 6 Seepage pit | <input checked="" type="checkbox"/> 11 Fuel Storage | 16 Other (specify below) |
| 2 Sewer lines | 7 Pit privy | 12 Fertilizer storage | _____ |
| 3 Watertight sewer lines | 8 Sewage lagoon | 13 Insecticide storage | _____ |
| 4 Lateral lines | 9 Feedyard | 14 Abandoned water well | Direction from well? <u>North</u> |
| 5 Cess pool | 10 Livestock pens | 15 Oil well/Gas well | How many feet? <u>100</u> |

FROM	TO	PLUGGING MATERIALS	FROM	TO	PLUGGING MATERIALS
<u>0</u>	<u>3 1/2</u>	<u>Topsoil</u>			
<u>3 1/2</u>	<u>7</u>	<u>Bentonite Plug</u>			
<u>7</u>	<u>142</u>	<u>Subsoil</u>			
<u>142</u>	<u>170</u>	<u>Chlorine/Gravel</u>			

7 CONTRACTOR'S OR LANDOWNER'S CERTIFICATION: This water well was plugged under my jurisdiction and was completed on (mo/day/year) _____ and this record is true to the best of my knowledge and belief. Kansas Water Well Contractor's License No. _____. This Water Well Record was completed on (mo/day/year) 3-23-16 under the business name of _____ by (signature) Charles Viehman

INSTRUCTIONS: Use typewriter or ballpoint pen. Please press firmly and print clearly. Please fill in blanks, underline or circle the correct answers. Send top three copies to Kansas Department of Health and Environment, Bureau of Water, Geology Section, 1000 SW Jackson St., Ste. 420, Topeka, Kansas 66612-1367. Telephone: 785/296-5522. Send one to Water Well Owner and retain one for your records. Visit us at <http://www.kdheks.gov/geo/waterwells>.