

WATER WELL PLUGGING RECORD Form WWC-5P

KSA 82a-1212

ID NO.

1 LOCATION OF WATER WELL: County: REPUBLIC	Fraction NW 1/4 NW 1/4 NW 1/4 SE 1/4	Section Number 2	Township Number T 1 S	Range Number 3 <input type="checkbox"/> E <input checked="" type="checkbox"/> W
--	---	---------------------	--------------------------	--

Street/Rural Address of Well Location; if unknown, distance & direction from nearest town or intersection: If at owner's address, check here ☐ FROM THE INTERSECTION OF ASH ROAD AND HWY 81 TRAVEL SOUTH FOR APPROX 3064 FT THEN WEST FOR APPROX 2508 FT


Global Positioning Systems (GPS) information:

Latitude: 39.993227 (in decimal degrees)
Longitude: 97.621909 (in decimal degrees)
Elevation: 1622
Horizontal Datum: ☐ WGS84, ☒ NAD83, ☐ NAD27
Collection Method:

2 WATER WELL OWNER: CITY OF BELLEVILLE
RR#, St. Address, Box #: 1819 L STREET
City, State ZIP Code: BELLEVILLE, KS 66935

☒ GPS unit (Make/Model: GARMIN
☐ Digital Map/Photo. ☐ Topographic Map. ☐ Land Survey
Est. Accuracy: ☒ < 3 m. ☐ 3-5 m. ☐ 5-15 m. ☐ > 15 m

3 MARK WELL'S LOCATION WITH AN "X" IN SECTION BOX:

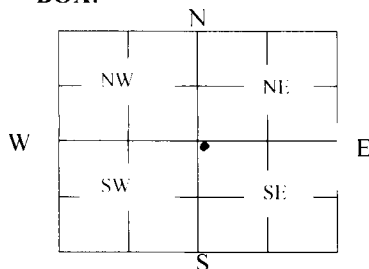

4 DEPTH OF WELL 231 ft.

WELL'S STATIC WATER LEVEL 140 ft

WELL WAS USED AS:

- | | | |
|-------------------------------------|---|--|
| <input type="checkbox"/> Domestic | <input type="checkbox"/> Public Water Supply | <input type="checkbox"/> Dewatering |
| <input type="checkbox"/> Irrigation | <input type="checkbox"/> Oil Field Water Supply | <input type="checkbox"/> Monitoring |
| <input type="checkbox"/> Feedlot | <input type="checkbox"/> Domestic (Lawn & Garden) | <input checked="" type="checkbox"/> Injection Well |
| <input type="checkbox"/> Industrial | <input type="checkbox"/> Air Conditioning | <input checked="" type="checkbox"/> Other TESTING |

Was a chemical/bacteriological sample submitted to Department? Yes ☐ No ☒

5 TYPE OF BLANK CASING USED:

- ☐ Steel ☐ RMP (SR) ☐ Wrought ☐ Fiberglass ☐ Other (Specify below)
☒ PVC ☐ ABS ☐ Asbestos-Cement ☐ Concrete Tile

Blank casing diameter 2.375 in. Was casing pulled? Yes ☐ No ☒ If yes, how much _____
Casing height above or below land surface 48 in.

6 GROUT PLUG MATERIAL:

- ☐ Neat cement ☐ Cement grout ☒ Bentonite ☐ Other _____

Grout Plug Intervals: From 5 ft. to 35 ft., From _____ ft. to _____ ft., From _____ ft. to _____ ft.

What is the nearest source of possible contamination:

- | | | | |
|---|---|---|--|
| <input type="checkbox"/> Septic tank | <input type="checkbox"/> Seepage pit | <input type="checkbox"/> Fuel storage | <input type="checkbox"/> Other (specify below) |
| <input type="checkbox"/> Sewer lines | <input type="checkbox"/> Pit privy | <input type="checkbox"/> Fertilizer storage | |
| <input type="checkbox"/> Watertight sewer lines | <input type="checkbox"/> Sewage lagoon | <input type="checkbox"/> Insecticide storage | |
| <input type="checkbox"/> Lateral lines | <input type="checkbox"/> Feedyard | <input type="checkbox"/> Abandoned water well | Direction from well? _____ |
| <input type="checkbox"/> Cess pool | <input type="checkbox"/> Livestock pens | <input type="checkbox"/> Oil well/Gas well | How many feet? _____ |

FROM	TO	PLUGGING MATERIALS	FROM	TO	PLUGGING MATERIALS
0	4	TOP SOIL			
4	5	CONCRETE CAP			
5	35	3/8" BENTONITE CHIPS			
35	231	ICE CONTROL GRAVEL			

7 CONTRACTOR'S OR LANDOWNER'S CERTIFICATION: This water well was plugged under my jurisdiction and was completed on (mo/day/year) 11/05/2019 and this record is true to the best of my knowledge and belief. Kansas Water Well Contractor's License No. 480. This Water Well Record was completed on (mo/day/year) 11/20/2019 under the business name of WILLIAMS DRILLING CO INC by (signature) *Ron Williams*

Send one white copy to Kansas Department of Health & Environment, Geology Section, 1000 SW Jackson Street, Ste. 420. Topeka, KS 66612-1367. Send one copy to WATER WELL OWNER and retain one for your records.
Visit us at _____ Telephone 785-296-5524.

KSA82a-1212

Revised 1/20/2015