

WATER WELL PLUGGING RECORD Form WWC-5P KSA 82a-1212 ID NO.


1 LOCATION OF WATER WELL: County: REPUBLIC	Fraction NW ¼ NW ¼ SW ¼ NW ¼	Section Number 2	Township Number T 1 S	Range Number 3 <input type="checkbox"/> E <input checked="" type="checkbox"/> W
--	---------------------------------	---------------------	--------------------------	--

Street/Rural Address of Well Location: if unknown, distance & direction from nearest town or intersection: If at owner's address, check here FROM THE INTERSECTION OF ASH ROAD AND 170 ROAD TRAVEL SOUTH FOR APPROX 1513 FT THEN EAST FOR APPROX 25 FT

Global Positioning Systems (GPS) information:
 Latitude: 39.997888 (in decimal degrees)
 Longitude: 97.631430 (in decimal degrees)
 Elevation: 1630
 Horizontal Datum: WGS84, NAD83, NAD27
 Collection Method:

2 WATER WELL OWNER: CITY OF BELLEVILLE
 RR#. St. Address, Box #: 1819 L STREET
 City, State ZIP Code: BELLEVILLE, KS 66935

GPS unit (Make/Model: GARMIN
 Digital Map/Photo. Topographic Map. Land Survey
 Est. Accuracy: < 3 m. 3-5 m. 5-15 m. > 15 m

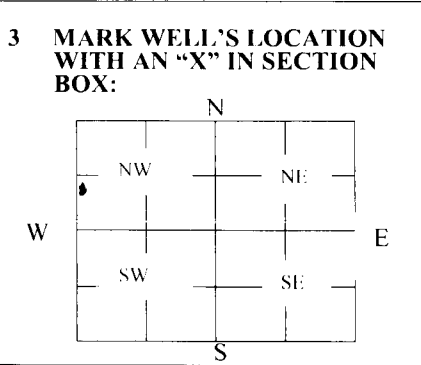

4 DEPTH OF WELL 187 ft.
 WELL'S STATIC WATER LEVEL 144 ft
 WELL WAS USED AS:
 Domestic Public Water Supply Dewatering
 Irrigation Oil Field Water Supply Monitoring
 Feedlot Domestic (Lawn & Garden) Injection Well
 Industrial Air Conditioning Other TESTING

Was a chemical/bacteriological sample submitted to Department? Yes No

5 TYPE OF BLANK CASING USED:

Steel RMP (SR) Wrought Fiberglass Other (Specify below)
 PVC ABS Asbestos-Cement Concrete Tile

Blank casing diameter 2.375 in. Was casing pulled? Yes No If yes, how much _____
 Casing height above or below land surface 48 in.

6 GROUT PLUG MATERIAL: Neat cement Cement grout Bentonite Other _____

Grout Plug Intervals: From 5 ft. to 35 ft., From _____ ft. to _____ ft., From _____ ft. to _____ ft.

What is the nearest source of possible contamination:
 Septic tank Seepage pit Fuel storage Other (specify below)
 Sewer lines Pit privy Fertilizer storage
 Watertight sewer lines Sewage lagoon Insecticide storage
 Lateral lines Feedyard Abandoned water well Direction from well? _____
 Cess pool Livestock pens Oil well/Gas well How many feet? _____

FROM	TO	PLUGGING MATERIALS	FROM	TO	PLUGGING MATERIALS
0	4	TOP SOIL			
4	5	CONCRETE CAP			
5	35	3/8" BENTONITE CHIPS			
35	187	ICE CONTROL GRAVEL			

7 CONTRACTOR'S OR LANDOWNER'S CERTIFICATION: This water well was plugged under my jurisdiction and was completed on (mo/day/year) 11/05/2019 and this record is true to the best of my knowledge and belief. Kansas Water Well Contractor's License No. 480. This Water Well Record was completed on (mo/day/year) 11/20/2019 under the business name of WILLIAMS DRILLING CO INC by (signature) *Ron Williams*