

WATER WELL PLUGGING RECORD Form WWC-5P KSA 82a-1212 ID NO.


1 LOCATION OF WATER WELL: County: Decatur Fraction CE 1/4 SE 1/4 SE 1/4 1/4 Section Number 31 Township Number T 1 S Range Number 30 [ ] E [X] W

Street/Rural Address of Well Location; if unknown, distance & direction from nearest town or intersection: If at owner's address, check here [ ]

Global Positioning Systems (GPS) information: Latitude: (in decimal degrees) Longitude: (in decimal degrees) Elevation: Datum: [ ] WGS84, [ ] NAD83, [ ] NAD27 Collection Method: [ ] GPS unit (Make/Model): [ ] Digital Map/Photo, [ ] Topographic Map, [ ] Land Survey Est. Accuracy: [ ] < 3 m, [ ] 3-5 m, [ ] 5-15 m, [ ] > 15 m

2 WATER WELL OWNER: Demmer Farms Inc. RR#, St. Address, Box #: 2466 400th Rd City, State ZIP Code: Oberlin, KS 67749

3 MARK WELL'S LOCATION WITH AN "X" IN SECTION BOX:

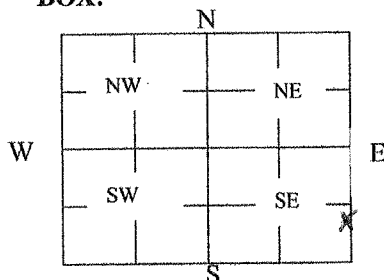

4 DEPTH OF WELL 44 ft.

WELL'S STATIC WATER LEVEL 12 ft

WELL WAS USED AS:

- [ ] Domestic [ ] Public Water Supply [ ] Dewatering
[X] Irrigation [ ] Oil Field Water Supply [ ] Monitoring
[ ] Feedlot [ ] Domestic (Lawn & Garden) [ ] Injection Well
[ ] Industrial [ ] Air Conditioning [ ] Other

Was a chemical/bacteriological sample submitted to Department? Yes [ ] No [X]

5 TYPE OF BLANK CASING USED:

- [ ] Steel [ ] RMP (SR) [ ] Wrought [ ] Fiberglass [ ] Other (Specify below)
[ ] PVC [ ] ABS [X] Asbestos-Cement [ ] Concrete Tile

Blank casing diameter 12 in. Was casing pulled? Yes [X] No [ ] If yes, how much 6 ft.
Casing height above or below land surface 48 in.

6 GROUT PLUG MATERIAL: [ ] Neat cement [ ] Cement grout [X] Bentonite [ ] Other

Grout Plug Intervals: From ft. to ft., From 12 ft. to 4 ft., From to ft.

What is the nearest source of possible contamination:

- [ ] Septic tank [ ] Seepage pit [ ] Fuel Storage [ ] Other (specify below)
[ ] Sewer lines [ ] Pit privy [ ] Fertilizer storage
[ ] Watertight sewer lines [ ] Sewage lagoon [ ] Insecticide storage
[ ] Lateral lines [ ] Feedyard [ ] Abandoned water well
[ ] Cess pool [X] Livestock pens [ ] Oil well/Gas well

Direction from well? NW
How many feet? 5400

Table with 6 columns: FROM, TO, PLUGGING MATERIALS, FROM, TO, PLUGGING MATERIALS. Rows include: 44 to 12 ft. Chlorinated sand; 12 to 4 ft. Bentonite; 4 to 0 ft. Native soil.

7 CONTRACTOR'S OR LANDOWNER'S CERTIFICATION: This water well was plugged under my jurisdiction and was completed on (mo/day/year) 6-1-12 and this record is true to the best of my knowledge and belief. Kansas Water Well Contractor's License No. This Water Well Record was completed on (mo/day/year) 6-4-12 under the business name of Demmer Farms Inc. by (signature)

INSTRUCTIONS: Use typewriter or ballpoint pen. Please press firmly and print clearly. Please fill in blanks, underline or circle the correct answers. Send top three copies to Kansas Department of Health and Environment, Bureau of Water, Geology Section, 1000 SW Jackson St., Ste. 420, Topeka, Kansas 66612-1367. Telephone: 785/296-5524. Send one to Water Well Owner and retain one for your records. Visit us at http://www.kdheks.gov/waterwell/index.html.