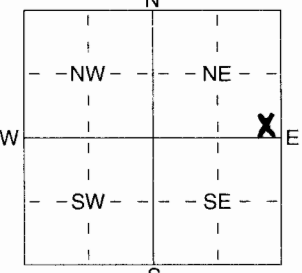


1 LOCATION OF WATER WELL: County: Rawlins Fraction: SE 1/4 SE 1/4 NE 1/4 Section Number: 20 Township Number: T 1 S Range Number: R 35 E W

Distance and direction from nearest town or city street address of well if located within city?
11 miles N - 6 miles east - 1 mile N of McDonald

2 WATER WELL OWNER: Shag Wilkinson
 RR#, St. Address, Box #: #C2 Board of Agriculture, Division of Water Resources
 City, State, ZIP Code: McDonald, KS 67745 Application Number:

3 LOCATE WELL'S LOCATION WITH AN "X" IN SECTION BOX:

 4 DEPTH OF COMPLETED WELL: 200 ft. ELEVATION:
 Depth(s) Groundwater Encountered: 1 177 ft. 2 177 ft. 3 ft.
 WELL'S STATIC WATER LEVEL: 177 ft. below land surface measured on mo/day/yr: 8-10-04
 Pump test data: Well water was ft. after hours pumping gpm
 Est. Yield: 5 gpm: Well water was ft. after hours pumping gpm
 WELL WATER TO BE USED AS:
 Domestic 3 Feedlot 6 Oil field water supply 9 Dewatering 12 Other (Specify below)
 Irrigation 4 Industrial 7 Domestic (lawn & garden) 10 Monitoring well
 Was a chemical/bacteriological sample submitted to Department? Yes No ; If yes, mo/day/yr sample was submitted Water Well Disinfected? Yes No

5 TYPE OF BLANK CASING USED:
 1 Steel 3 RMP (SR) 5 Wrought iron 8 Concrete tile CASING JOINTS: Glued Clamped
 2 PVC 4 ABS 6 Asbestos-Cement 9 Other (specify below) Welded
 Blank casing diameter: 5 in. to 160 ft., Dia in. to ft., Dia in. to ft.
 Casing height above land surface: 12 in., weight 200 PSI lbs./ft. Wall thickness or gauge No. SDR 17
 TYPE OF SCREEN OR PERFORATION MATERIAL:
 1 Steel 3 Stainless Steel 5 Fiberglass 8 RMP (SR) 10 Asbestos-Cement
 2 Brass 4 Galvanized Steel 6 Concrete tile 9 ABS 11 Other (Specify)
 7 PVC 12 None used (open hole)
 SCREEN OR PERFORATION OPENINGS ARE:
 1 Continuous slot 3 Mill slot 5 Gauzed wrapped 8 Saw cut 11 None (open hole)
 2 Louvered shutter 4 Key punched 6 Wire wrapped 9 Drilled holes
 7 Torch cut 10 Other (specify) ft.
 SCREEN-PERFORATED INTERVALS: From 160 ft. to 200 ft., From ft. to ft.
 GRAVEL PACK INTERVALS: From ft. to ft., From ft. to ft.
pea gravel From 30 ft. to 200 ft., From ft. to ft.

6 GROUT MATERIAL: 1 Neat cement 2 Cement grout 3 Bentonite 4 Other
 Grout Intervals: From 0 ft. to 30 ft., From ft. to ft., From ft. to ft.
 What is the nearest source of possible contamination:
 1 Septic tank 4 Lateral lines 7 Pit privy 10 Livestock pens 14 Abandoned water well
 2 Sewer lines 5 Cess pool 8 Sewage lagoon 11 Fuel storage 15 Oil well/Gas well
 3 Watertight sewer lines 6 Seepage pit 9 Feedyard 12 Fertilizer storage 16 Other (specify below)
 13 Insecticide storage
 Direction from well? None in View How many feet?

FROM	TO	LITHOLOGIC LOG	FROM	TO	PLUGGING INTERVALS
0	120	Clay			
120	140	gravel + sand			
140	160	gravel + clay			
160	180	sand + clay			
180	188	gravel			
188	200	Shale			

7 CONTRACTOR'S OR LANDOWNER'S CERTIFICATION: This water well was (1) constructed (2) reconstructed, or (3) plugged under my jurisdiction and was completed on (mo/day/year) 8-10-04 and this record is true to the best of my knowledge and belief. Kansas Water Well Contractor's Licence No. 484 This Water Well Record was completed on (mo/day/yr) 9-17-04 under the business name of Schaal Drilling, Co. by (signature) [Signature]