


1 LOCATION OF WATER WELL: County: Rawlins Fraction: NE 1/4 SE 1/4 SE 1/4 Section Number: 12 Township Number: T 1 S Range Number: R 36 E/W

Distance and direction from nearest town or city street address of well if located within city?
1.3 miles North of McDonald, KS

2 WATER WELL OWNER: Doug Downing
 RR#, St. Address, Box #: HC 2 Box 259
 City, State, ZIP Code: McDonald, KS 64745
 Board of Agriculture, Division of Water Resources
 Application Number:

3 LOCATE WELL'S LOCATION WITH AN "X" IN SECTION BOX:
 4 DEPTH OF COMPLETED WELL: 207 ft. ELEVATION:

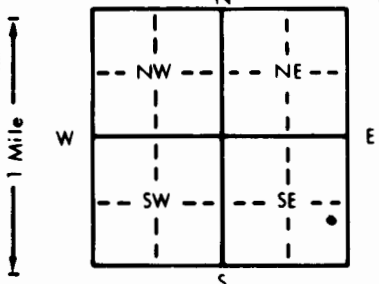

Depth(s) Groundwater Encountered 1. 192 ft. 2. ft. 3. ft.
 WELL'S STATIC WATER LEVEL 192 ft. below land surface measured on mo/day/yr 2/26/05
 Pump test data: Well water was _____ ft. after _____ hours pumping _____ gpm
 Est. Yield 10 gpm: Well water was 195 ft. after 2 hours pumping 14 gpm
 Bore Hole Diameter 8.75 in. to _____ ft. and _____ in. to _____ ft.
 WELL WATER TO BE USED AS:
 Domestic 3 Feedlot 6 Oil field water supply 9 Dewatering 12 Other (Specify below)
 2 Irrigation 4 Industrial 7 Lawn and garden only 10 Monitoring well
 Was a chemical/bacteriological sample submitted to Department? Yes _____ No If yes, mo/day/yr sample was submitted
 Water Well Disinfected? Yes No

5 TYPE OF BLANK CASING USED:
 1 Steel 3 RMP (SR) 5 Wrought iron 8 Concrete tile CASING JOINTS: Glued Clamped
 2 PVC 4 ABS 6 Asbestos-Cement 9 Other (specify below) Welded
 7 Fiberglass Threaded

Blank casing diameter 5 in. to 218 ft. Dia _____ in. to _____ ft. Dia _____ in. to _____ ft.
 Casing height above land surface 18 in., weight 291.41 lbs./ft. Wall thickness or gauge No. 265

TYPE OF SCREEN OR PERFORATION MATERIAL:
 1 Steel 3 Stainless steel 5 Fiberglass 8 RMP (SR) 10 Asbestos-cement
 2 Brass 4 Galvanized steel 6 Concrete tile 9 ABS 11 Other (specify)
 12 None used (open hole)

SCREEN OR PERFORATION OPENINGS ARE:
 1 Continuous slot 3 Mill slot 5 Gauzed wrapped 8 Saw cut 11 None (open hole)
 2 Louvered shutter 4 Key punched 6 Wire wrapped 9 Drilled holes
 7 Torch cut 10 Other (specify)

SCREEN-PERFORATED INTERVALS: From 218 ft. to 238 ft. From _____ ft. to _____ ft.
 From _____ ft. to _____ ft. From _____ ft. to _____ ft.
 GRAVEL PACK INTERVALS: From 20 ft. to 238 ft. From _____ ft. to _____ ft.
 From _____ ft. to _____ ft. From _____ ft. to _____ ft.

6 GROUT MATERIAL: 1 Neat cement 2 Cement grout 3 Bentonite 4 Other
 Grout Intervals: From 20 ft. to 5 ft., From 5 ft. to 0 ft., From _____ ft. to _____ ft.

What is the nearest source of possible contamination:
 1 Septic tank 4 Lateral lines 7 Pit privy 10 Livestock pens 14 Abandoned water well
 2 Sewer lines 5 Cess pool 8 Sewage lagoon 11 Fuel storage 15 Oil well/Gas well
 3 Watertight sewer lines 6 Seepage pit 9 Feedyard 12 Fertilizer storage 16 Other (specify below)
 13 Insecticide storage

Direction from well? east of well How many feet? 50'

FROM	TO	LITHOLOGIC LOG	FROM	TO	PLUGGING INTERVALS
0	145	Soil + clay			
145	174	Clay, some sandstone + lime			
174	176	sandstone + lime			
176	185	Fine sand to small gravel			
185	186	Flint			
186	195	Fine to coarse sand, some small gravel			
195	205	Fine to coarse sand, some small gravel, & flint + other			
205	212	flint, then shale			

7 CONTRACTOR'S OR LANDOWNER'S CERTIFICATION: This water well was (1) constructed, (2) reconstructed, or (3) plugged under my jurisdiction and was completed on (mo/day/year) 2/26/05 and this record is true to the best of my knowledge and belief. Kansas Water Well Contractor's License No. 495475 This Water Well Record was completed on (mo/day) 3/1/05 under the business name of Burton Well Drilling, Inc. by (signature) [Signature]