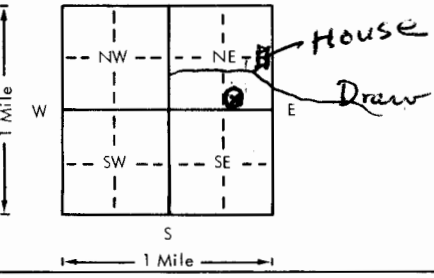


Sheet #5 For

USE TYPEWRITER OR BALL  
POINT PEN-PRESS FIRMLY,  
PRINT CLEARLY.

WATER WELL RECORD  
KSA 82a-1201-1215

Kansas Department of Health and  
Environment-Division of Environment  
(Water well Contractors)  
Topeka, Kansas 66620

1. Location of well:		County <b>Republic</b>	Fraction <b>SW 1/4 SE 1/4 NE 1/4</b>	Section number <b>1</b>	Township number <b>T 1 S R 4 E/W</b>	Range number <b>4</b>
2. Distance and direction from nearest town or city: <b>2 3/4 E. of Harbome</b>			3. Owner of well: <b>Layne Holmes</b>			
Street address of well location if in city:			R.R. or street: <b>2470 130 Rd.</b>			
			City, state, zip code: <b>Byron, NE 68325</b>			
4. Locate with "X" in section below:		Sketch map:		6. Bore hole dia. <b>28</b> in. Completion date <b>6-21-04</b> Well depth <b>184</b> ft.		
				7. <input type="checkbox"/> Cable tool <input type="checkbox"/> Rotary <input type="checkbox"/> Driven <input type="checkbox"/> Dug <input type="checkbox"/> Hollow rod <input type="checkbox"/> Jetted <input type="checkbox"/> Bored <input checked="" type="checkbox"/> Reverse rotary		
5. Type and color of material		From To		8. Use: <input type="checkbox"/> Domestic <input type="checkbox"/> Public supply <input type="checkbox"/> Industry <input checked="" type="checkbox"/> Irrigation <input type="checkbox"/> Air conditioning <input type="checkbox"/> Stock <input type="checkbox"/> Lawn <input type="checkbox"/> Oil field water <input type="checkbox"/> Other		
Topsoil & sandy clay		3 107		9. Casing: Material <input type="checkbox"/> Height: Above or below Threaded <input type="checkbox"/> Welded <input type="checkbox"/> Surface <b>12</b> in. RMP <input type="checkbox"/> PVC <input checked="" type="checkbox"/> Weight <b>19.3</b> lbs./ft. Dia. <b>16</b> in. to <b>144</b> ft. depth Wall Thickness: inches or Dia. <input type="checkbox"/> in. to <input type="checkbox"/> ft. depth gage No. <b>SDR 26</b>		
sand & small gravel		107 120		10. Screen: Manufacturer's name <b>Certa Int'l</b> Type <b>slotted</b> Dia. <b>16</b> Slot/gauze <b>.085</b> Length <b>40'</b> Set between <b>144</b> ft. and <b>184</b> ft. Gravel pack? <input checked="" type="checkbox"/> Size range of material <b>1/8 - 3/16</b>		
sand & small to medium gravel		120 179		11. Static water level: <input type="checkbox"/> mo./day/yr. <b>161</b> ft. below land surface Date <b>6/21/04</b>		
shale		179 184		12. Pumping level below land surfaces: <b>177</b> ft. after <b>1</b> hrs. pumping <b>500</b> g.p.m. <b>171</b> ft. after <b>12</b> hrs. pumping <b>300</b> g.p.m. Estimated maximum yield <b>500</b> g.p.m.		
				13. Water sample submitted: <input type="checkbox"/> Yes <input checked="" type="checkbox"/> No Date <input type="checkbox"/>		
				14. Well head completion: <input type="checkbox"/> Pitless adapter <b>12</b> inches above grade		
				15. Well grouted? <input checked="" type="checkbox"/> With: <input type="checkbox"/> Neat cement <input type="checkbox"/> Bentonite <input checked="" type="checkbox"/> Concrete Depth: From <b>0</b> ft. to <b>20</b> ft.		
				16. Nearest source of possible contamination: ft. <b>1000</b> Direction <b>EAST</b> Type <b>House</b> Well disinfected upon completion? <input checked="" type="checkbox"/> Yes <input type="checkbox"/> No		
				17. Pump: <input type="checkbox"/> Not installed Manufacturer's name <b>Western Land Roller</b> Model number <b>6706L</b> HP <input type="checkbox"/> Volts <input type="checkbox"/> Length of drop pipe <b>175</b> ft. capacity <b>500</b> g.p.m. Type: <input type="checkbox"/> Submersible <input checked="" type="checkbox"/> Turbine <input type="checkbox"/> Jet <input type="checkbox"/> Reciprocating <input type="checkbox"/> Centrifugal <input type="checkbox"/> Other		
18. Elevation:		19. Remarks:		20. Water well contractor's certification:		
Topography: <input type="checkbox"/> Hill <input type="checkbox"/> Slope <input checked="" type="checkbox"/> Upland <input type="checkbox"/> Valley		<b>File No. 23256</b>		This well was drilled under my jurisdiction and this report is true to the best of my knowledge and belief. <b>SHUCK DRILLING Co.</b> <b>272</b> Business name License No. Address <b>EDGAR, NE 68935</b> Signed <b>Dale Shuck</b> Date <b>9/5/03</b> Authorized representative		

Forward the white, blue and pink copies to the Department of Health and Environment

Form WWC-5