WATER WELL PLUGGING RECORD Form WWC-5P KSA 82a-1212 ID NO.

1 LOCATION OF WATER WELL: County: Republic	Fraction ¼ SW ¼ NE ¼	Section Number 29	Township Number 1	Range Number 4 E/W

Distance and direction from nearest town or city street address of well if located within city?

1/2 mile North and 1 1 /2 miles East of REpublic, KS

2 WATER WELL OWNER: Verle Tietjen

RR#, St. Address, Box #: 401 N. Railroad St.

City, State ZIP Code: Byron, NE 68325

Global Positioning Systems (decimal degrees, min. of 4 digits
Latitude: 39° 56' 24"
Longitude: 097° 47' 22.7"
Elevation:
Datum:
Data Collection Method: Hand held

3 MARK WELL'S LOCATION WITH AN "X" IN SECTION BOX:

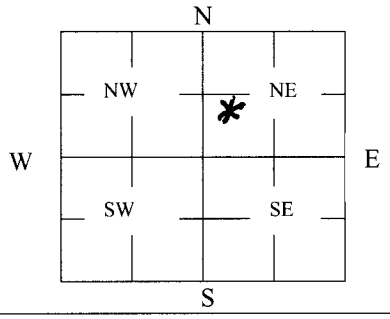

4 DEPTH OF WELL 69 ft.

WELL'S STATIC WATER LEVEL 22 ft

WELL WAS USED AS:

1 Domestic
2 Irrigation
3 Feedlot
4 Industrial
5 Public Water Supply
6 Oil Field Water Supply
7 Domestic (Lawn & Garden)
8 Air Conditioning
9 Dewatering
10 Monitoring
11 Injection Well
12 Other

Was a chemical/bacteriological sample submitted to Department? Yes ____ No X

5 TYPE OF BLANK CASING USED:

1 Steel
2 PVC
3 RMP (SR)
4 ABS
5 Wrought
6 Asbestos-Cement
7 Fiberglass
8 Concrete Tile
9 Other (Specify below)

Blank casing diameter 16 in. Was casing pulled? Yes ____ No X If yes, how much
Casing height above or below land surface 12 in.

6 GROUT PLUG MATERIAL: 1 Neat cement 2 Cement grout 3 Bentonite 4 Other

Grout Plug Intervals: From 4 ft. to 5 ft., From 5 ft. to 22 ft., From ____ to ____ ft.

What is the nearest source of possible contamination:

1 Septic tank
2 Sewer lines
3 Watertight sewer lines
4 Lateral lines
5 Cess pool
6 Seepage pit
7 Pit privy
8 Sewage lagoon
9 Feedyard
10 Livestock pens
11 Fuel Storage
12 Fertilizer storage
13 Insecticide storage
14 Abandoned water well
15 Oil well/Gas well
16 Other (specify below)

Direction from well? East
How many feet? 100'

FROM	TO	PLUGGING MATERIALS	FROM	TO	PLUGGING MATERIALS
0'	4'	Native soil			
4'	5'	Bentonite cap			
5'	22'	Bentonite grout			
22'	69'	Chlorinated gravel			

7 CONTRACTOR'S OR LANDOWNER'S CERTIFICATION: This water well was plugged under my jurisdiction and was completed on (mo/day/year) 4/14/2009 and this record is true to the best of my knowledge and belief. Kansas Water Well Contractor's License No. 755. This Water Well Record was completed on (mo/day/year) 5/14/2009 under the business name of Sargent Drilling by (signature) [signature].

INSTRUCTIONS: Use typewriter or ballpoint pen. Please press firmly and print clearly. Please fill in blanks, underline or circle the correct answers. Send top three copies to Kansas Department of Health and Environment, Bureau of Water, Geology Section, 1000 SW Jackson St., Ste. 420, Topeka, Kansas 66612-1367. Telephone: 785/296-5522. Send one to Water Well Owner and retain one for your records. Visit us at http://www.kdheks.gov/geo/waterwells.