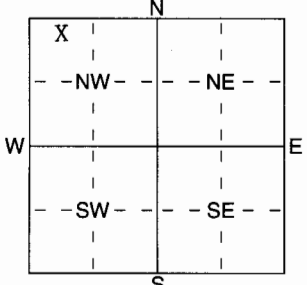


1 LOCATION OF WATER WELL: County: Cheyenne Fraction: NW 1/4 NW 1/4 NW 1/4 Section Number: 33 Township Number: T 1 S Range Number: R 41 E **(W)**

Distance and direction from nearest town or city street address of well if located within city?  
6 miles south & 1/8 east of Haigler, Nebraska

2 WATER WELL OWNER: Marvin Kamla  
 RR#, St. Address, Box # : P.O. Box 38  
 City, State, ZIP Code : Haigler, NE 69030  
 Board of Agriculture, Division of Water Resources  
 Application Number:

3 LOCATE WELL'S LOCATION WITH AN "X" IN SECTION BOX:  
  
 4 DEPTH OF COMPLETED WELL: 82 ft. ELEVATION: ..... ft.  
 Depth(s) Groundwater Encountered: 1 41 ft. 2 ..... ft. 3 ..... ft.  
 WELL'S STATIC WATER LEVEL: 41 ft. below land surface measured on 03/25/2005  
 Pump test data: Well water was ..... ft. after ..... hours pumping ..... gpm  
 Est. Yield ..... gpm: Well water was ..... ft. after ..... hours pumping ..... gpm  
 WELL WATER TO BE USED AS:  
 1 Domestic     3 Feedlot     6 Oil field water supply     9 Dewatering     12 Other (Specify below)  
 2 Irrigation     4 Industrial     7 Domestic (lawn & garden)     10 Monitoring well  
 Was a chemical/bacteriological sample submitted to Department? Yes ..... No X..... If yes, mo/day/yr sample was submitted  
 Water Well Disinfected? **(Yes)** No

5 TYPE OF BLANK CASING USED:  
 1 Steel     3 RMP (SR)     5 Wrought iron     8 Concrete tile    CASING JOINTS: Glued X Clamped .....  
 2 PVC     4 ABS     6 Asbestos-Cement     9 Other (specify below)    Welded .....  
 7 Fiberglass    Threaded .....  
 Blank casing diameter: 5 in. to 4.5 ft., Dia: 5 in. to 7.5 ft. ~~XXX~~ To 8.2 ft.  
 Casing height above land surface: 24 in., weight Pitless Unit lbs./ft. Wall thickness or guage No. ....  
 TYPE OF SCREEN OR PERFORATION MATERIAL:  
 1 Steel     3 Stainless Steel     5 Fiberglass     7 PVC     10 Asbestos-Cement  
 2 Brass     4 Galvanized Steel     6 Concrete tile     8 RMP (SR)     11 Other (Specify) .....  
 12 None used (open hole)  
 SCREEN OR PERFORATION OPENINGS ARE:  
 1 Continuous slot     3 Mill slot     5 Guazed wrapped     8 Saw cut     11 None (open hole)  
 2 Louvered shutter     4 Key punched     6 Wire wrapped     9 Drilled holes  
 7 Torch cut     10 Other (specify) ..... ft.  
 SCREEN-PERFORATED INTERVALS: From 45 ft. to 77 ft., From ..... ft. to ..... ft.  
 From ..... ft. to ..... ft., From ..... ft. to ..... ft.  
 GRAVEL PACK INTERVALS: From 26 ft. to 82 ft., From ..... ft. to ..... ft.  
 From ..... ft. to ..... ft., From ..... ft. to ..... ft.

6 GROUT MATERIAL:  1 Neat cement     2 Cement grout     3 Bentonite     4 Other .....  
 Grout Intervals: From 0 ft. to 26 ft., From ..... ft. to ..... ft., From ..... ft. to ..... ft.  
 What is the nearest source of possible contamination:  
 1 Septic tank     4 Lateral lines     7 Pit privy     10 Livestock pens     14 Abandoned water well  
 2 Sewer lines     5 Cess pool     8 Sewage lagoon     11 Fuel storage     15 Oil well/Gas well  
 3 Watertight sewer lines     6 Seepage pit     9 Feedyard     12 Fertilizer storage     16 Other (specify below)  
 13 Insecticide storage .....  
 Direction from well? How many feet? 100 +

FROM	TO	LITHOLOGIC LOG	FROM	TO	PLUGGING INTERVALS
0	1	top soil			
1	20	silty clay			
20	22	sandy clay			
22	29	fine to medium sand			
29	40	sandy clay with magnesium			
40	44	sandy clay			
44	50	fine gravel			
50	56	sandy clay			
56	75	ochre			
75	100	shale			

7 CONTRACTOR'S OR LANDOWNER'S CERTIFICATION: This water well was (1) constructed, (2) reconstructed, or (3) plugged under my jurisdiction and was completed on (mo/day/year) 03/25/2005 and this record is true to the best of my knowledge and belief. Kansas Water Well Contractor's Licence No 711 This Water Well Record was completed on (mo/day/yr) 04/30/2005 under the business name of Chas. Sargent Irrigation Inc. by (signature) Chas Sargent

INSTRUCTIONS: Use typewriter or ball point pen. PLEASE PRESS FIRMLY and PRINT clearly. Please fill in blanks, underline or circle the correct answers. Send top three copies to Kansas Department of Health and Environment, Bureau of Water, Geology Section, 1000 SW Jackson St., Suite 420, Topeka, Kansas 66612-1367. Telephone 785-296-5522. Send one to WATER WELL OWNER and retain one for your records. Fee of \$5.00 for each constructed well.