

County: Republic Fraction NE SW SW NE Sec. 36 T 1 S R 5 E (W)

CORRECTION(S) TO WATER WELL COMPLETION RECORD (WWC-5)

(to rectify lacking or incorrect information)

Owner: Crop Production Services

Location was listed as:

Section-Township-Range: 36-15-5W

Fraction (1/4 1/4 1/4): None Given

Location changed to:

36-15-5W

NE SW SW NE

Other changes: Initial statements: _____

Changed to: _____

Comments: _____

Verification method: Latitude & longitude, KGS' "LEO" conversion tool, wellsite address & city street map, and mapping tool on KGS website.

initials: ARL date: 10/5/2012

Submitted by: Kansas Geological Survey, Data Resources Library, 1930 Constant Ave., Lawrence, KS 66047-3726

to: Kansas Dept of Health & Environment, Bureau of Water, 1000 SW Jackson, Suite 420, Topeka, KS 66612-1367.

WATER WELL RECORD

Form WWC-5


Division of Water Resources App. No.

Blank box for application number

1 LOCATION OF WATER WELL: County: Republic, Fraction 1/4 1/4 1/4 1/4, Section Number 36, Township No. T 1 S, Range Number R 5, E W

Street/Rural Address of Well Location; if unknown, distance & direction from nearest town or intersection: If at owner's address, check here []. 310 Broadway Street, Republic, KS 66964. Global Positioning System (GPS) information: Latitude: 39.9233, Longitude: 97.8267

2 WATER WELL OWNER: Crop Production Services, RR#, Street Address, Box #: 3005 Rockv Mountain Avenue, City, State, ZIP Code : Loveland, CO 80538. Collection Method: [x] GPS unit (Make/Model: Garmin GPS 12), [] Digital Map/Photo, [] Topographic Map, [] Land Survey, Est. Accuracy: [] <3 m, [x] 3-5 m, [] 5-15 m, [] >15 m

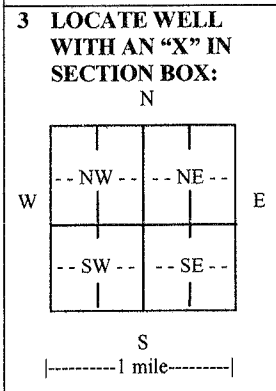

3 LOCATE WELL WITH AN "X" IN SECTION BOX: N, W, E, S. 4 DEPTH OF COMPLETED WELL 30.0' ft. Depth(s) Groundwater Encountered (1)..... ft. (2)..... ft. (3)..... ft. WELL'S STATIC WATER LEVEL...14.20' ft. below land surface measured on mo/day/yr. 6/27/12. Pump test data: Well water was.....ft. after..... hours pumping..... gpm. EST. YIELD.....gpm. Well water was.....ft. after..... hours pumping..... gpm. Bore Hole Diameter 8.50".....in. to 30.0'.....ft., andin. toft. WELL WATER TO BE USED AS: [] Public water supply [] Geothermal [] Injection well [] Domestic [] Feedlot [] Oil field water supply [] Dewatering [] Other (Specify below) [] Irrigation [] Industrial [] Domestic-lawn & garden [x] Monitoring well REW-5. Was a chemical/bacteriological sample submitted to Department? [] Yes [x] No. If yes, mo/day/yr sample was submitted..... Water well disinfected? [] Yes [x] No

5 TYPE OF CASING USED: [] Steel [x] PVC [] Other. CASING JOINTS: [] Glued [] Clamped [] Welded [x] Threaded. Casing diameter 2"..... in. to .10.0'..... ft., Diameter in. to ft., Diameter in. to ft. Casing height above land surface .3.0'..... in., Weightlbs./ft., Wall thickness or gauge No. Sch. 40. TYPE OF SCREEN OR PERFORATION MATERIAL: [] Steel [] Stainless Steel [x] PVC [] Other (Specify) [] Brass [] Galvanized Steel [] None used (open hole). SCREEN OR PERFORATION OPENINGS ARE: [] Continuous slot [x] Mill slot [] Gauze wrapped [] Torch cut [] Drilled holes [] None (open hole) [] Louvered shutter [] Key punched [] Wire wrapped [] Saw cut [] Other (specify) SCREEN-PERFORATED INTERVALS: From...10.0'..... ft. to .30.0'..... ft., From ft. to ft. From..... ft. to ft., From ft. to ft. GRAVEL PACK INTERVALS: From...8.0'..... ft. to .30.0'..... ft., From ft. to ft. From..... ft. to ft., From ft. to ft.

6 GROUT MATERIAL: [] Neat cement [] Cement grout [x] Bentonite [] Other. Grout Intervals: From .0..... ft. to 8.0'..... ft., From ft. to ft., From ft. to ft. What is the nearest source of possible contamination: [] Septic tank [] Lateral lines [] Pit privy [] Livestock pens [] Insecticide storage [] Other (specify below) [] Sewer lines [] Cesspool [] Sewage lagoon [] Fuel storage [] Abandoned water well [] Watertight sewer lines [] Seepage pit [] Feedyard [] Fertilizer storage [] Oil well/gas well. Direction from well Distance from well

Table with columns: FROM, TO, LITHOLOGIC LOG, FROM, TO, LITHO. LOG (cont.) or PLUGGING INTERVALS. Rows: 0-2' Dark Brown Clay Fill, 2'-5' Lt. Brn Sandy Silt. Moist, 5'-31' Light Brown Sand, Wet, 31' End Of Boring.

7 CONTRACTOR'S OR LANDOWNER'S CERTIFICATION: This water well was [x] constructed, [] reconstructed, or [] plugged under my jurisdiction and was completed on (mo/day/year) 6/26/12..... and this record is true to the best of my knowledge and belief. Kansas Water Well Contractor's License No. 606..... This Water Well Record was completed on (mo/day/year) 6/24/12..... under the business name of PSA Environmental..... by (signature).....

INSTRUCTIONS: Use typewriter or ball point pen. PLEASE PRESS FIRMLY and PRINT clearly. Please fill in blanks and check the correct answers. Send three copies (white, blue, pink) to Kansas Department of Health and Environment, Bureau of Water, Geology Section, 1000 SW Jackson St., Suite 420, Topeka, Kansas 66612-1367. Telephone 785-296-5522. Send one copy to WATER WELL OWNER and retain one for your records. Include fee of \$5.00 for each constructed well. Visit us at http://www.kdheks.gov/waterwell/index.html.