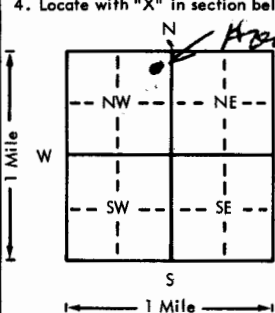


USE TYPEWRITER OR BALL  
POINT PEN-PRESS FIRMLY  
PRINT CLEARLY

WATER WELL RECORD  
KSA 82a-1201-1215

Kansas Department of Health and  
Environment-Division of Environment  
(Water well Contractors)  
Topeka, Kansas 66620

1. Location of well? County <u>McPherson</u>		Fraction <u>NE NW</u> <u>1/4 SW 1/4 NE 1/4</u>	Section number <u>4</u>	Township number <u>T 20 S</u>	Range number <u>R 1 E NW</u>
2. Distance and direction from nearest town or city: Street address of well location if in city: <u>2 MILE SO. 1/2 WEST CANTON KANSAS</u>			3. Owner of well: <u>HERMIT BECKER</u> R.R. or street: <u>RR CANTON KANSAS 67428</u> City, state, zip code:		
4. Locate with "X" in section below: Sketch map: 			6. Bore hole dia. <u>8</u> in. Completion date <u>11-10-76</u> Well depth <u>70</u> ft.		
5. Type and color of material			7. <input checked="" type="checkbox"/> Cable tool <input checked="" type="checkbox"/> Rotary <input type="checkbox"/> Driven <input type="checkbox"/> Dug <input type="checkbox"/> Hollow rod <input type="checkbox"/> Jetted <input type="checkbox"/> Bored <input type="checkbox"/> Reverse rotary		
			8. Use: <input checked="" type="checkbox"/> Domestic <input type="checkbox"/> Public supply <input type="checkbox"/> Industry <input type="checkbox"/> Irrigation <input type="checkbox"/> Air conditioning <input type="checkbox"/> Stock <input type="checkbox"/> Lawn <input type="checkbox"/> Oil field water <input type="checkbox"/> Other		
			9. Casing: Material <u>PVC</u> Height: Above or below Threaded <input type="checkbox"/> Welded <input checked="" type="checkbox"/> Surface <u>24</u> in. RMP <input type="checkbox"/> PVC <input checked="" type="checkbox"/> Weight <u>7</u> lbs./ft. Dia. <u>4</u> in. to <u>70</u> ft. depth Wall Thickness: inches or Dia. <u>4</u> in. to <u>70</u> ft. depth gage No. <u>      </u>		
			10. Screen: Manufacturer's name <u>CELESTRESS</u> Type <u>PVC</u> Dia. <u>4"</u> Slot/gauze <u>4/16</u> Length <u>10</u> Set between <u>60</u> ft. and <u>70</u> ft. <u>      </u> ft. and <u>      </u> ft. Gravel pack? <u>yes</u> Size range of material <u>1/4"</u>		
11. Static water level: <u>32</u> ft. below land surface Date <u>11-10-76</u> mo./day/yr.			12. Pumping level below land surfaces: <u>51</u> ft. after <u>1 1/2</u> hrs. pumping <u>10</u> g.p.m. <u>      </u> ft. after <u>      </u> hrs. pumping <u>      </u> g.p.m. Estimated maximum yield <u>25</u> g.p.m.		
13. Water sample submitted: <u>      </u> mo./day/yr. <u>      </u> Yes <input checked="" type="checkbox"/> No <input type="checkbox"/> Date <u>      </u>			14. Well head completion: <u>no</u> <u>      </u> Pitless adapter <u>      </u> inches above grade		
15. Well grouted? <u>yes</u> With: <input checked="" type="checkbox"/> Neat cement <input type="checkbox"/> Bentonite <input type="checkbox"/> Concrete Depth: From <u>0</u> ft. to <u>10</u> ft.			16. Nearest source of possible contamination: <u>500</u> ft. <u>150</u> Direction <u>South</u> Type <u>Shade</u> Well disinfected upon completion? <input checked="" type="checkbox"/> Yes <input type="checkbox"/> No		
17. Pump: <input checked="" type="checkbox"/> Not installed Manufacturer's name <u>      </u> Model number <u>      </u> HP <u>      </u> Volts <u>      </u> Length of drop pipe <u>      </u> ft. capacity <u>      </u> g.p.m. Type: <input type="checkbox"/> Submersible <input type="checkbox"/> Turbine <input type="checkbox"/> Jet <input type="checkbox"/> Reciprocating <input type="checkbox"/> Centrifugal <input type="checkbox"/> Other			18. Elevation:  Topography: <input type="checkbox"/> Hill <input type="checkbox"/> Slope <input checked="" type="checkbox"/> Upland <input type="checkbox"/> Valley		
19. Remarks:  <u>Cord 70 ft @ \$6.00</u>			20. Water well contractor's certification: This well was drilled under my jurisdiction and this report is true to the best of my knowledge and belief. <u>Peterson Bros Inc 138A</u> License No. <u>      </u> Business name <u>Box 150 LINDSACK KS</u> Address <u>Wellington</u> Signed <u>      </u> Date <u>12-1-76</u> Authorized representative <u>      </u>		