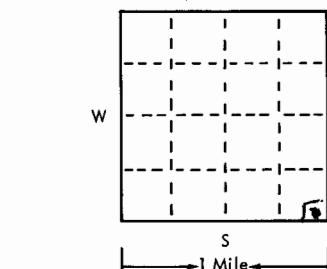
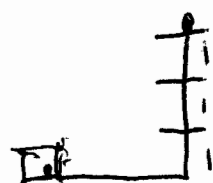


USE TYPEWRITER OR BALL
POINT PEN-PRESS FIRMLY,
PRINT CLEARLY.

WATER WELL RECORD
KSA 82a-1201-1215

2051W SSeSeSe
T R EW sec 1/4 1/4 1/4 No.

Kansas State Dept. Of Health
(Water Well Contractors)
Forbes-Bldg. 740
Topeka, Kansas 66620

1 Location of well:		County McPherson	Township name Canton	Fraction SE SE SE	Section number 5	Town number 20 S	Range number 1 W		
Distance and direction from nearest town or city: 3 miles south, west				3 Owner of well: Blackstone Drilling					
Street address of well location if in city: of Canton, Kansas				Address: McPherson, Kansas 67460					
Locate with "X" in section below:		Sketch map:		4 Well depth: <u>90</u> ft. Date of completion <u>2-11-78</u> Well diameter <u>6</u> in.					
				5 <input type="checkbox"/> Cable tool <input checked="" type="checkbox"/> Rotary <input type="checkbox"/> Driven <input type="checkbox"/> Dug <input type="checkbox"/> Hollow rod <input type="checkbox"/> Jetted <input type="checkbox"/> Bored <input type="checkbox"/> Reverse rotary					
2		Type and color of material		From		To		6 Use: <input type="checkbox"/> Domestic <input type="checkbox"/> Public supply <input type="checkbox"/> Industry <input type="checkbox"/> Irrigation <input type="checkbox"/> Air conditioning <input type="checkbox"/> Commercial <input type="checkbox"/> Test well <input checked="" type="checkbox"/> oil well water	
								7 Casing: Material <u>Plastic</u> Height: above/below Threaded <input type="checkbox"/> Welded <input type="checkbox"/> Surface <u>18</u> in. Diam. <u>PVC</u> Weight <u>10</u> lbs./ft. <u>3</u> in. to <u>70</u> ft. depth Drive shoe? <input type="checkbox"/> Yes <input checked="" type="checkbox"/> No <u>1</u> in. to <u>90</u> ft. depth	
								8 Screen: Manufacturer <u>Certain teed</u> Type <u>Sawed</u> Dia. <u>3</u> Slot/gauze <u>1/4</u> Length <u>20</u> Set between <u>70</u> ft. and <u>90</u> ft. Fittings: Gravel pack <input checked="" type="checkbox"/> Yes <input type="checkbox"/> No Size range of material <u>4</u>	
								9 Static water level: <u>30</u> ft. below land surface Date <u>2-11-78</u>	
								10 Pumping level below land surfaces: <u>35</u> ft. after <u>1</u> hrs. pumping <u>30</u> g.p.m. ____ ft. after ____ hrs. pumping ____ g.p.m. Estimated maximum yield <u>30</u> g.p.m.	
								11 Water sample submitted: <input type="checkbox"/> Yes <input checked="" type="checkbox"/> No Date _____	
								12 Well head completion: <input type="checkbox"/> Pitless adapter <u>18</u> inches above grade	
								13 Well grouted? <input checked="" type="checkbox"/> Yes <input type="checkbox"/> No <input type="checkbox"/> Neat cement <input checked="" type="checkbox"/> Bentonite <input type="checkbox"/> _____ Depth: From ____ ft. to <u>10</u> ft.	
								14 Nearest source of possible contamination: ft. ____ Direction <u>none</u> Type ____ Well disinfected upon completion? <input type="checkbox"/> Yes <input checked="" type="checkbox"/> No	
								15 Pump: <input checked="" type="checkbox"/> Not installed Manufacturer's name _____ Model number _____ HP _____ Volts _____ Length of drop pipe _____ ft. capacity _____ g.p.m. Type: <input type="checkbox"/> Submersible <input type="checkbox"/> Turbine <input type="checkbox"/> Jet <input type="checkbox"/> Reciprocating <input type="checkbox"/> Centrifugal <input type="checkbox"/> Other	
16 Remarks: elevation				17 Water well contractor's certification: This well was drilled under my jurisdiction and this report is true to the best of my knowledge and belief. <u>Darling Drilling Co.</u> <u>189</u> Business name License No. Address <u>121 W. 4th, Hutchinson,</u> Signed <u>Donald J. Darling</u> Date <u>2-15-78</u> Authorized representative					