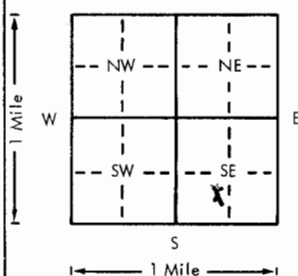
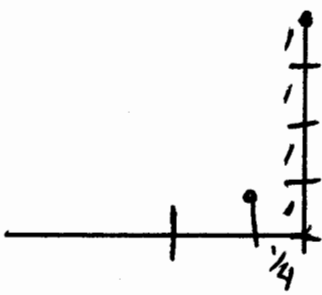


USE TYPEWRITER OR BALL  
POINT PEN-PRESS FIRMLY,  
PRINT CLEARLY.

WATER WELL RECORD  
KSA 82a-1201-1215

Kansas Department of Health and  
Environment-Division of Environment  
(Water well Contractors)  
Topeka, Kansas 66620

1. Location of well:	County <b>McPherson</b>	Fraction <b>NE 1/4 SW 1/4</b>	Section number <b>9</b>	Township number <b>T 20</b>	Range number <b>R 1 E</b>
2. Distance and direction from nearest town or city: Street address of well location if in city: <b>4 miles south of Canton, 1/4 west, 1/4 north</b>		3. Owner of well: <b>Blackstone Drilling Co.</b> R.R. or street: <b>P.O. Box 1184</b> City, state, zip code: <b>McPherson, Kansas 67460</b>			
4. Locate with "X" in section below:		Sketch map:		6. Bore hole dia. <b>6</b> in. Completion date <b>3/21/79</b> Well depth <b>80</b> ft.	
				7. Cable tool <input checked="" type="checkbox"/> Rotary <input type="checkbox"/> Driven <input type="checkbox"/> Dug <input type="checkbox"/> Hollow rod <input type="checkbox"/> Jetted <input type="checkbox"/> Bored <input type="checkbox"/> Reverse rotary	
5. Type and color of material		From	To	8. Use: <input type="checkbox"/> Domestic <input type="checkbox"/> Public supply <input type="checkbox"/> Industry <input type="checkbox"/> Irrigation <input type="checkbox"/> Air conditioning <input type="checkbox"/> Stock <input type="checkbox"/> Lawn <input checked="" type="checkbox"/> Oil field water <input type="checkbox"/> Other	
Top soil		0	3	9. Casing: Material <b>Plastic</b> Height: Above or below Threaded <input type="checkbox"/> Welded <input type="checkbox"/> Surface <b>18</b> in. RMP <input type="checkbox"/> PVC <input checked="" type="checkbox"/> Weight <b>18</b> lbs./ft.	
Clay		3	38	Dial <b>3</b> in. to <b>60</b> ft. depth Wall Thickness: inches or Dial <b>8</b> in. to <b>60</b> ft. depth gage No. <b>216</b>	
Med. sand		38	47	10. Screen: Manufacturer's name <b>Certain Feed</b> Type <b>sawed</b> Dia. <b>3</b> Slot/gauze <b>1/4</b> Length <b>28</b> Set between <b>60</b> ft. and <b>80</b> ft. ft. and <b>80</b> ft.	
Clay		47	55	Gravel pack? <b>yes</b> Size range of material <b>1/8 - 3/4</b>	
Med. sand		55	60	11. Static water level: <b>11</b> ft. below land surface Date <b>3/21/79</b>	
Med. sand		60	67	12. Pumping level below land surfaces: <b>15</b> ft. after <b>1</b> hrs. pumping <b>80</b> g.p.m. <b>80</b> g.p.m.	
Med. sand		67	80	Estimated maximum yield <b>80</b> g.p.m.	
Shale		80		13. Water sample submitted: <b>no./day/yr.</b> <input type="checkbox"/> Yes <input checked="" type="checkbox"/> No Date	
				14. Well head completion: <b>18</b> inches above grade <input type="checkbox"/> Pitless adapter	
				15. Well grouted <b>yes</b> With: <input checked="" type="checkbox"/> Neat cement <input type="checkbox"/> Bentonite <input type="checkbox"/> Concrete Depth: From <b>0</b> ft. to <b>10</b> ft.	
				16. Nearest source of possible contamination: <b>none</b> ft. <b>none</b> Direction <b>none</b> Type <b>none</b> Well disinfected upon completion? <input type="checkbox"/> Yes <input checked="" type="checkbox"/> No	
				17. Pump: <input checked="" type="checkbox"/> Not installed Manufacturer's name <b>X</b> Model number <b>X</b> HP <b>X</b> Volts <b>X</b> Length of drop pipe <b>X</b> ft. capacity <b>X</b> g.p.m. Type: <input type="checkbox"/> Submersible <input type="checkbox"/> Turbine <input type="checkbox"/> Jet <input type="checkbox"/> Reciprocating <input type="checkbox"/> Centrifugal <input type="checkbox"/> Other	
18. Elevation:		19. Remarks:		20. Water well contractor's certification: This well was drilled under my jurisdiction and this report is true to the best of my knowledge and belief. <b>Rosencrantz-Bemis Ent. Inc. 131</b> Business name License No. <b>1211 W. 4th, Hutchinson, Kansas</b> Address Signed <b>Mike Powers</b> Date <b>6-22-79</b> Authorized representative	