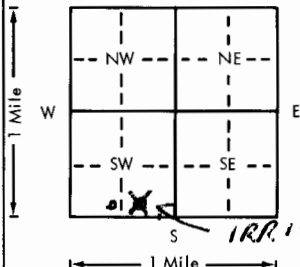


USE TYPEWRITER OR BALL
POINT PEN-PRESS FIRMLY,
PRINT CLEARLY.

WATER WELL RECORD
KSA 82a-1201-1215

Kansas Department of Health and
Environment-Division of Environment
(Water well Contractors)
Topeka, Kansas 66620

1. Location of well:		County McPherson	Fraction SW SE SW 1/4	Section number 15	Township number T 20 S R 1 W	Range number 1 W
2. Distance and direction from nearest town or city: 5 S 1/2 E Street address of well location if in city: CANTON, KS.				3. Owner of well: LLOYD VOGTS R.R. or street: R.R. #2 City, state, zip code: CANTON, KS 67428		
4. Locate with "X" in section below:		Sketch map:		6. Bore hole dia. 30 in. Completion date 7-9-77 Well depth 72 ft.		
				7. <input type="checkbox"/> Cable tool <input type="checkbox"/> Rotary <input type="checkbox"/> Driven <input type="checkbox"/> Dug <input type="checkbox"/> Hollow rod <input type="checkbox"/> Jetted <input type="checkbox"/> Bored <input checked="" type="checkbox"/> Reverse rotary		
5. Type and color of material				8. Use: <input type="checkbox"/> Domestic <input type="checkbox"/> Public supply <input type="checkbox"/> Industry <input checked="" type="checkbox"/> Irrigation <input type="checkbox"/> Air conditioning <input type="checkbox"/> Stock <input type="checkbox"/> Lawn <input type="checkbox"/> Oil field water <input type="checkbox"/> Other		
				9. Casing: Material IRON Height: Above or below Threaded <input type="checkbox"/> Welded <input type="checkbox"/> Surface 12 in. RMP <input type="checkbox"/> PVC <input type="checkbox"/> Weight 32 lbs./ft. Dia. 16 in. to 22 ft. depth Wall Thickness: inches or Dia. <input type="checkbox"/> in. to <input type="checkbox"/> ft. depth Gauge No. 175 M		
				10. Screen: Manufacturer's name AURORA TILE COMPANY Type TRANSITE Dia. 16" Slot/gauze 18 in Length 20 ft Set between 52 ft. and 72 ft. ft. and <input type="checkbox"/> ft. Gravel pack? YES Size range of material 1/4 in		
				11. Static water level: <input type="checkbox"/> mo./day/yr. 12 ft. below land surface Date 7-9-77		
				12. Pumping level below land surfaces: 60 ft. after 3 hrs. pumping 400 g.p.m. <input type="checkbox"/> ft. after <input type="checkbox"/> hrs. pumping <input type="checkbox"/> g.p.m. Estimated maximum yield 400 g.p.m.		
				13. Water sample submitted: <input type="checkbox"/> mo./day/yr. <input type="checkbox"/> Yes <input checked="" type="checkbox"/> No Date <input type="checkbox"/>		
				14. Well head completion: <input type="checkbox"/> Pitless adapter 12 Inches above grade		
				15. Well grouted? YES PUDDLE CLAY With: <input type="checkbox"/> Neat cement <input type="checkbox"/> Bentonite <input type="checkbox"/> Concrete Depth: From 0 ft. to 10 ft.		
				16. Nearest source of possible contamination: P16 ft. SW Direction E Type FACM Well disinfected upon completion? <input type="checkbox"/> Yes <input checked="" type="checkbox"/> No		
				17. Pump: <input type="checkbox"/> Not installed Manufacturer's name WESTERN LAND RIGGS Model number 4M HP 20 Volts <input type="checkbox"/> Length of drop pipe 60 ft. capacity 400 g.p.m. Type: <input type="checkbox"/> Submersible <input checked="" type="checkbox"/> Turbine <input type="checkbox"/> Jet <input type="checkbox"/> Reciprocating <input type="checkbox"/> Centrifugal <input type="checkbox"/> Other		
(Use a second sheet if needed)						
18. Elevation:		19. Remarks:		20. Water well contractor's certification: This well was drilled under my jurisdiction and this report is true to the best of my knowledge and belief. PETERSON IRRIGATION 138A Business name Box 150, LINCOLN, KS License No. <input type="checkbox"/> Address Box 150, LINCOLN, KS Signed Mike Peterson Date 7-25-77 Authorized representative		
Topography: <input type="checkbox"/> Hill <input type="checkbox"/> Slope <input checked="" type="checkbox"/> Upland <input type="checkbox"/> Valley						

20-10-15 SW SE SW