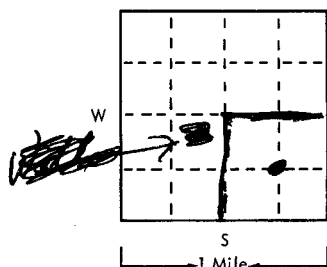


T		R		EW		sec	1/4	1/4	1/4 No

WATER WELL RECORD
KSA 82g-1201-1215

Kansas State Dept. Of Health
(Water Well Contractors)
Forbes-Bldg. 740
Topeka, Kansas 66620

County McPherson		Township name SPRING VALLEY		Fraction SE 1/4		Section number 17		Town number T205		Range number R-1-W	
1 Location of well: Distance and direction from nearest town or city: Street address of well location if in city:						3 Owner of well: Address:					
Locate with "X" in section below: 						Sketch map: Irrigation well is located in center of SE 1/4.					
2 Type and color of material						From		To		4 Well depth: 91 ft. Date of completion 1-27-15 Well diameter 32 in.	
										5 <input type="checkbox"/> Cable tool <input type="checkbox"/> Rotary <input type="checkbox"/> Driven <input type="checkbox"/> Dug <input type="checkbox"/> Hollow rod <input type="checkbox"/> Jetted <input type="checkbox"/> Bored <input checked="" type="checkbox"/> Reverse rotary	
BLACK TOP SOIL PINK CLAY HARD FINE SAND LIMEROUS PINK CLAY HARD FINE SAND LOOSE - FINE TO MEDIUM SANDS SHALE @						6 Use: <input type="checkbox"/> Domestic <input type="checkbox"/> Public supply <input type="checkbox"/> Industry <input checked="" type="checkbox"/> Irrigation <input type="checkbox"/> Air conditioning <input type="checkbox"/> Commercial <input type="checkbox"/> Test well		6 Use: <input type="checkbox"/> Domestic <input type="checkbox"/> Public supply <input type="checkbox"/> Industry <input checked="" type="checkbox"/> Irrigation <input type="checkbox"/> Air conditioning <input type="checkbox"/> Commercial <input type="checkbox"/> Test well		7 Casing: Material TRANSITE Height: above below Threaded <input type="checkbox"/> Welded <input type="checkbox"/> Surface 12 in. Diam. 16 in. to 91 ft. depth Drive shoe? <input type="checkbox"/> Yes <input type="checkbox"/> No 16 in. to 91 ft. depth	
						7 Casing: Material TRANSITE Height: above below Threaded <input type="checkbox"/> Welded <input type="checkbox"/> Surface 12 in. Diam. 16 in. to 91 ft. depth Drive shoe? <input type="checkbox"/> Yes <input type="checkbox"/> No 16 in. to 91 ft. depth		8 Screen: Manufacturer JOHN MANFELD Type TRANSITE Dia. 16 in. 18 Slot/gauge 1/8 in. Length 39 ft. Set between 52 ft. and 91 ft. Fittings: Gravel pack <input checked="" type="checkbox"/> Yes <input checked="" type="checkbox"/> No Size range of material 1/4			
						9 Static water level: 19 ft. below land surface Date 1-27-15		10 Pumping level below land surfaces: 80 ft. after 2 hrs. pumping 500 g.p.m. ft. after hrs. pumping g.p.m. Estimated maximum yield 500 g.p.m.		11 Water sample submitted: <input type="checkbox"/> Yes <input checked="" type="checkbox"/> No Date	
						11 Water sample submitted: <input type="checkbox"/> Yes <input checked="" type="checkbox"/> No Date		12 Well head completion: 12 in. <input type="checkbox"/> Pitless adapter <input checked="" type="checkbox"/> Inches above grade			
						13 Well grouted? <input checked="" type="checkbox"/> Yes <input type="checkbox"/> No Puddled clay <input type="checkbox"/> Neat cement <input type="checkbox"/> Bentonite <input type="checkbox"/> Clay Depth: From 0 ft. to 20 ft.		14 Nearest source of possible contamination: ft. 40 Direction NE Type Farm Well disinfected upon completion? <input type="checkbox"/> Yes <input checked="" type="checkbox"/> No			
						14 Nearest source of possible contamination: ft. 40 Direction NE Type Farm Well disinfected upon completion? <input type="checkbox"/> Yes <input checked="" type="checkbox"/> No		15 Pump: <input type="checkbox"/> Not installed Manufacturer's name WESTERN LAND CO. Model number 8m HP 1 Volts 115 Length of drop pipe 25 ft. capacity g.p.m. Type: <input type="checkbox"/> Submersible <input checked="" type="checkbox"/> Turbine <input type="checkbox"/> Jet <input type="checkbox"/> Reciprocating <input type="checkbox"/> Centrifugal <input type="checkbox"/> Other			
16 Remarks: elevation FLAT LAND This pump will operate on Natural Flow.						17 Water well contractor's certification: This well was drilled under my jurisdiction and this report is true to the best of my knowledge and belief. Peter W. Bess, Inc. License No. 138 Address Box 150 Lyons, Mo. 64583 Signed Wesley Bess Date 1-27-15 Authorized representative					