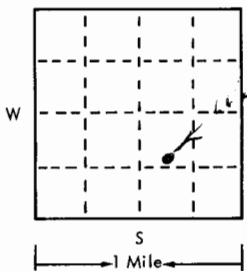
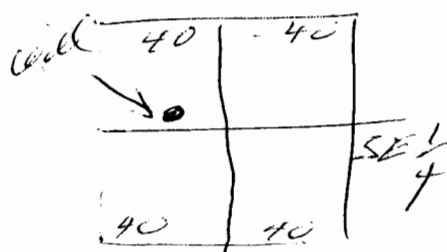


USE TYPEWRITER OR BALL
POINT PEN-PRESS FIRMLY,
PRINT CLEARLY.

WATER WELL RECORD
KSA 82a-1201-1215

T R EW sec 1/4 1/4 1/4 No.

Kansas State Dept. Of Health
(Water Well Contractors)
Forbes-Bldg. 740
Topeka, Kansas 66620

1 Location of well:	County <u>McPherson</u>	Township name <u>Spring Valley</u>	Fraction <u>SE 1/4</u>	Section number <u>17</u>	Town number <u>20 S</u>	Range number <u>R 1 W</u>
Distance and direction from nearest town or city: <u>4.50 16th canton, KS</u>				3 Owner of well: <u>LAWRENCE BULLINGER, JR</u>		
Street address of well location if in city:				Address: <u>R. 2 E Canton, KS 66605</u>		
Locate with "X" in section below:		Sketch map:		4 Well depth: <u>78</u> ft. Date of completion <u>5-12-75</u> Well diameter <u>30</u> in.		
				5 <input type="checkbox"/> Cable tool <input type="checkbox"/> Rotary <input type="checkbox"/> Driven <input type="checkbox"/> Dug <input type="checkbox"/> Hollow rod <input type="checkbox"/> Jetted <input type="checkbox"/> Bored <input checked="" type="checkbox"/> Reverse rotary		
2		Type and color of material		From	To	6 Use: <input type="checkbox"/> Domestic <input type="checkbox"/> Public supply <input type="checkbox"/> Industry <input checked="" type="checkbox"/> Irrigation <input type="checkbox"/> Air conditioning <input type="checkbox"/> Commercial <input type="checkbox"/> Test well
		BLACK Top soil		0	1	7 Casing: Material <u>Plastic</u> Height: above/below Threaded <input type="checkbox"/> Welded <input type="checkbox"/> Surface <input type="checkbox"/> in. Diam. <u>16</u> in. to <u>78</u> ft. depth Drive shoe? <input type="checkbox"/> Yes <input checked="" type="checkbox"/> No in. to in. ft. depth
		DARK clay		1	8	8 Screen: Manufacturer <u>Tetco Manufacturing</u> Type <u>TRANSITE</u> Dia. <u>16</u> Slot/gauze <u>1/8</u> Length <u>39.6</u> Set between <u>39</u> ft. and <u>78</u> ft. Fittings: <u>39</u> Gravel pack <input checked="" type="checkbox"/> Yes <input type="checkbox"/> No Size range of material <u>4</u>
		GRAY clay		8	12	9 Static water level: <u>28</u> ft. below land surface Date <u>5-12-75</u>
		Red sand stone lime rock		12	36	10 Pumping level below land surfaces: <u>65</u> ft. after <u>2</u> hrs. pumping <u>470</u> g.p.m. ft. after hrs. pumping g.p.m. Estimated maximum yield <u>470</u> g.p.m.
		Very fine sand & clay		36	44	11 Water sample submitted: <input type="checkbox"/> Yes <input checked="" type="checkbox"/> No Date
		TITE Very fine sand		44	58	12 Well head completion: <u>no</u> <input type="checkbox"/> Pitless adapter <u>12</u> inches above grade
		Med sand - loose		58	75	13 Well grouted? <input checked="" type="checkbox"/> Yes <input type="checkbox"/> No <input type="checkbox"/> Neat cement <input type="checkbox"/> Bentonite <input type="checkbox"/> <u>Reddish clay</u> Depth: From <u>0</u> ft. to <u>10</u> ft.
		good water loss				14 Nearest source of possible contamination: ft. <u>1300</u> Direction <u>NE</u> Type <u>well</u> Well disinfected upon completion? <input type="checkbox"/> Yes <input checked="" type="checkbox"/> No
		Green shale		75	80	15 Pump: <input checked="" type="checkbox"/> Not installed Manufacturer's name <u>Western Lumber</u> Model number <u>4111</u> HP <u>25</u> Volts Length of drop pipe <u>700</u> ft. capacity <u>450</u> g.p.m. Type: <input type="checkbox"/> Submersible <input checked="" type="checkbox"/> Turbine <input type="checkbox"/> Jet <input type="checkbox"/> Reciprocating <input type="checkbox"/> Centrifugal <input type="checkbox"/> Other
		(use a second sheet if needed)				17 Water well contractor's certification: This well was drilled under my jurisdiction and this report is true to the best of my knowledge and belief. <u>Peterson Bros Inc</u> License No. <u>138</u> Business name <u>Bos 150 University KS</u> Address <u>Wellman Dr Peterson</u> Date <u>5-12-75</u> Signed <u>Wellman Dr Peterson</u> Authorized representative
16 Remarks: elevation						
Topography: <input type="checkbox"/> Hill <input type="checkbox"/> Slope <input type="checkbox"/> Upland <input type="checkbox"/> Valley						