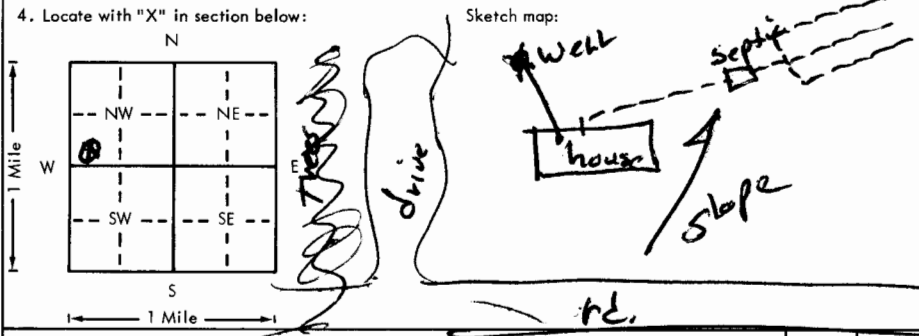


USE TYPEWRITER OR BALL  
POINT PEN-PRESS FIRMLY,  
PRINT CLEARLY.

WATER WELL RECORD  
KSA 82a-1201-1215

Kansas Department of Health and  
Environment-Division of Environment  
(Water well Contractors)  
Topeka, Kansas 66620

1. Location of well:		County <b>Mcpherson</b>	Fraction <b>SW 1/4 SW 1/4 NW 1/4</b>	Section number <b>34</b>	Township number <b>T 20 S R 1 E</b>	Range number <b>1</b>
2. Distance and direction from nearest town or city: <b>9 mile N-Heaton</b>			3. Owner of well: <b>George Etheridge</b> R.R. #1 <b>CANTON, KNS</b>			
4. Locate with "X" in section below: 			6. Bore hole dia. <b>12</b> in. Completion date <b>7/16/77</b> Well depth <b>12</b> ft.			
5. Type and color of material			7. <input checked="" type="checkbox"/> Cable tool <input checked="" type="checkbox"/> Rotary <input type="checkbox"/> Driven <input type="checkbox"/> Dug <input type="checkbox"/> Hollow rod <input type="checkbox"/> Jetted <input type="checkbox"/> Bored <input type="checkbox"/> Reverse rotary			
			8. Use: <input checked="" type="checkbox"/> Domestic <input type="checkbox"/> Public supply <input type="checkbox"/> Industry <input type="checkbox"/> Irrigation <input type="checkbox"/> Air conditioning <input type="checkbox"/> Stock <input type="checkbox"/> Lawn <input type="checkbox"/> Oil field water <input type="checkbox"/> Other			
			9. Casing: Material <b>plastic</b> Height: Above or below Threaded <input type="checkbox"/> Welded <input checked="" type="checkbox"/> Surface <input type="checkbox"/> in. RMP <input type="checkbox"/> PVC <input checked="" type="checkbox"/> Weight <input type="checkbox"/> lbs./ft. Dia. <b>6</b> in. to <input type="checkbox"/> ft. depth Wall Thickness: inches or Dia. <input type="checkbox"/> in. to <input type="checkbox"/> ft. depth gage No. <b>280</b>			
			10. Screen: Manufacturer's name <b>Robin-Tech-own slot</b> Type <b>pvc</b> Dia. <b>6"</b> Slot/gauze <b>.046</b> Length <b>20'</b> Set between <b>30'</b> ft. and <b>50'</b> ft. Gravel pack? <input checked="" type="checkbox"/> Size range of material <b>1/8-1/4</b>			
			11. Static water level: <input type="checkbox"/> mo./day/yr. <b>9</b> ft. below land surface Date <b>7/16/77</b>			
			12. Pumping level below land surfaces: <b>19</b> ft. after <b>2</b> hrs. pumping <b>20</b> g.p.m. <b>25</b> ft. after <b>30</b> hrs. pumping <b>20/40</b> g.p.m. Estimated maximum yield <b>20/40</b> g.p.m.			
			13. Water sample submitted: <input type="checkbox"/> mo./day/yr. <input type="checkbox"/> Yes <input checked="" type="checkbox"/> No Date <b>7/16/77</b>			
			14. Well head completion: <input checked="" type="checkbox"/> Pitless adapter <input type="checkbox"/> Inches above grade			
			15. Well grouted? <input checked="" type="checkbox"/> With: <input checked="" type="checkbox"/> Neat cement <input type="checkbox"/> Bentonite <input type="checkbox"/> Concrete Depth: From <b>10</b> ft. to <b>0</b> ft.			
			16. Nearest source of possible contamination: ft. <b>60</b> Direction <b>SE</b> Type <b>Sewer</b> Well disinfected upon completion? <input checked="" type="checkbox"/> Yes <input type="checkbox"/> No			
			17. Pump: <input type="checkbox"/> Not installed Manufacturer's name <b>Dempster</b> Model number <b>DMF-3352</b> Volts <b>230</b> Length of drop pipe <b>40'</b> ft. capacity <b>12</b> g.p.m. Type: <input checked="" type="checkbox"/> Submersible <input type="checkbox"/> Turbine <input type="checkbox"/> Jet <input type="checkbox"/> Reciprocating <input type="checkbox"/> Centrifugal <input type="checkbox"/> Other			
18. Elevation:			20. Water well contractor's certification: This well was drilled under my jurisdiction and this report is true to the best of my knowledge and belief. <b>PAUL'S INC #175</b> Business name <b>Heaton, KNS</b> License No. Address <b>Paul Rudhart</b> Signed <b>Paul Rudhart</b> Date <b>7/18/77</b> Authorized representative			
19. Remarks:						