

USE TYPEWRITER OR BALL  
POINT PEN-PRESS FIRMLY,  
PRINT CLEARLY.

WATER WELL RECORD  
KSA 82a-1201-1215

Kansas Department of Health and  
Environment-Division of Environment  
(Water well Contractors)  
Topeka, Kansas 66620

|   |  |  |   |  |  |              |
|---|--|--|---|--|--|--------------|
| 1. Location of well:  |  | County<br><u>McPherson</u>   | Fraction<br><u>NW 1/4 SE 1/4 NW 1/4</u>                                       | Section number<br><u>9</u>   | Township number<br><u>T 20</u> (S) R <u>1</u> E <u>W</u> | Range number |
| 2. Distance and direction from nearest town or city: <u>3.3 miles S</u>   |  |  | 3. Owner of well: <u>Reiney Voght (For Rural water Dist. Hillsboro, Kans)</u> |  |  |              |
| Street address of well location if in city: <u>40.74 miles W of Canton, Kans</u>  |  |  | City, state, zip code: <u>Canton, Kans</u>                                    |  |  |              |
| 4. Locate with "X" in section below:  |  | Sketch map:  |   | 6. Bore hole dia. <u>4</u> in. Completion date <u>5-04-76</u><br>Well depth <u>98</u> ft.  |  |              |
|   |  | <p><i>This Obsv. well</i><br/><i>50' x 120'</i><br/><i>Voght irrigation well</i><br/><i>Cultivated field</i></p> |   | 7. Cable tool <input checked="" type="checkbox"/> Rotary <input type="checkbox"/> Driven <input type="checkbox"/> Dug<br><input type="checkbox"/> Hollow rod <input type="checkbox"/> Jetted <input type="checkbox"/> Bored <input type="checkbox"/> Reverse rotary  |  |              |
|   |  |  |   | 8. Use: <input type="checkbox"/> Domestic <input type="checkbox"/> Public supply <input type="checkbox"/> Industry<br><input type="checkbox"/> Irrigation <input type="checkbox"/> Air conditioning <input type="checkbox"/> Stock<br><input type="checkbox"/> Lawn <input type="checkbox"/> Oil field water <input checked="" type="checkbox"/> Other   |  |              |
| 5. Type and color of material   |  | From   | To  | 9. Casing: Material <u>PVC</u> Height: <u>Above</u> or below<br>Threaded <input type="checkbox"/> Welded <input type="checkbox"/> Surface <u>1.4</u> in.<br>RMP <input type="checkbox"/> PVC Weight <input type="checkbox"/> lbs./ft.<br>Dia. <u>2</u> in. to <u>98</u> ft. depth Wall Thickness: inches or<br>Dia. <input type="checkbox"/> in. to <input type="checkbox"/> ft. depth gage No. <input type="checkbox"/>   |  |              |
| <u>Pleistocene &amp; Pliocene:</u>  |  |  |   | 10. Screen: Manufacturer's name <u>shop</u><br>Type <u>PVC</u> Dia. <u>2"</u><br>Slot/gauze <u>1/16"</u> Length <u>20 ft</u><br>Set between <u>78</u> ft. and <u>98</u> ft.<br>ft. and <input type="checkbox"/> ft.<br>Gravel pack? <input checked="" type="checkbox"/> Size range of material <u>2 mm</u>   |  |              |
| <u>Clay, tan, gray, green, buff &amp; cream</u>   |  | <u>0</u>   | <u>39</u>   | 11. Static water level: <input type="checkbox"/> mo./day/yr.<br><u>35.03</u> ft. below land surface Date <u>May 7, 76</u>  |  |              |
| <u>Sand, medium to fine</u>   |  | <u>39</u>  | <u>54</u>   | 12. Pumping level below land surfaces:<br>ft. after <u>0.5</u> hrs. pumping <u>10</u> g.p.m.<br>ft. after <input type="checkbox"/> hrs. pumping <input type="checkbox"/> g.p.m.<br>Estimated maximum yield <input type="checkbox"/> g.p.m.   |  |              |
| <u>Clay, brown</u>  |  | <u>54</u>  | <u>55</u>   | 13. Water sample submitted: <input type="checkbox"/> Yes <input checked="" type="checkbox"/> No Date <u>-30 ppm Cl</u> mo./day/yr.   |  |              |
| <u>Gravel fine to coarse &amp; sand, some clay</u>  |  | <u>55</u>  | <u>96</u>   | 14. Well head completion:<br><input type="checkbox"/> Pitless adapter <u>15</u> inches above grade   |  |              |
| <u>interbedded 62 to 68</u>   |  |  |   | 15. Well grouted? <u>no</u><br>With: <input type="checkbox"/> Neat cement <input type="checkbox"/> Bentonite <input type="checkbox"/> Concrete<br>Depth: From <input type="checkbox"/> ft. to <input type="checkbox"/> ft.   |  |              |
| <u>Wellington fm:</u>   |  |  |   | 16. Nearest source of possible contamination:<br>ft. <input type="checkbox"/> Direction <input type="checkbox"/> Type <input type="checkbox"/><br>Well disinfected upon completion? <input type="checkbox"/> Yes <input type="checkbox"/> No   |  |              |
| <u>Shale, gray-green</u>  |  | <u>96</u>  | <u>98</u>   | 17. Pump: <input checked="" type="checkbox"/> Not installed<br>Manufacturer's name <input type="checkbox"/><br>Model number <input type="checkbox"/> HP <input type="checkbox"/> Volts <input type="checkbox"/><br>Length of drop pipe <input type="checkbox"/> ft. capacity <input type="checkbox"/> g.p.m.<br>Type:<br><input type="checkbox"/> Submersible <input type="checkbox"/> Turbine<br><input type="checkbox"/> Jet <input type="checkbox"/> Reciprocating<br><input type="checkbox"/> Centrifugal <input type="checkbox"/> Other |  |              |
| (Use a second sheet if needed)  |  |  |   | 20. Water well contractor's certification:<br>This well was drilled under my jurisdiction and this report<br>is true to the best of my knowledge and belief.<br><u>Reiney Voght Co</u> License No. <u>126</u><br>Business name <u>282 S. 1st St. Topeka, Kans</u><br>Address <u>John F. Voght</u> Date <u>May 17, 76</u><br>Signed <u>John F. Voght</u> Authorized representative  |  |              |
| 18. Elevation:  |  | 19. Remarks:   |   | 20. Water well contractor's certification:   |  |              |
| Topography:<br><input type="checkbox"/> Hill<br><input checked="" type="checkbox"/> Slope<br><input type="checkbox"/> Upland<br><input type="checkbox"/> Valley |  | Well used as No. 1 obsv well for<br>pumptest. Casing pulled & hole<br>after pumping & recovery measure           |   | 20. Water well contractor's certification:<br>This well was drilled under my jurisdiction and this report<br>is true to the best of my knowledge and belief.

**O. S. FENT**  
 Consulting Geologist  
 ROUTE 2  
 SALINA, KANSAS 67401

PHONE TA 7-1971

May 13, 1976



Foster - Van Gundy and Associates  
 Ellsworth, Kansas

Enclosed are the graphs of the pumping test, recovery measurements and logs of observation wells near the Rodney Voght irrigation well in the NW $\frac{1}{4}$  Sec. 9, T.20S., R.1W., McPherson County, Kansas.

With a pump intake setting of 95 ft. below land surface in the well, the well will pump continuously at the following rates for the listed lengths of time before the pumping level reaches the pump intake:

- 850 gallons per minute, 19 years
- 1000 gallons per minute, 2.85 years
- 1300 gallons per minute, 41 days

A pumping rate of 1000 gallons per minute at low head and 850 gallons at higher head should be planned for this well under conditions of 24 hour per day pumping. Normal recharge from rainfall should increase the time-yield of the well to span low rainfall years. (See last segment of drawdown graphs)

Field tests on a water sample taken near the end of the pumping showed 222 parts per million hardness, less than 1 ppm nitrate, 22 ppm chloride and a combined iron and manganese level that could be objectionable under some conditions. A laboratory confirmation on these metals on May 13 yielded iron, 0.28 parts per million and manganese, 0.40 part per million.

The drawdown curves reflect recharge at about 300 minutes into the test. At this time, additional recharge reaching the aquifer is reflected in a flattening of the graph lines, indicating higher productivity for longer periods of pumping. This recharge is probably from recent rains. All time and quantity computations were made on the hydrologic characteristics of the formation on the steeper part of the graph and do not reflect the current recharge. Calculations based upon the flatter segments of the graph, that reflecting the recharge, nearly double the pumping times listed under paragraph 2.


Because of some old oil-field contamination to the west of this area is known and because there is some renewed oil field activity in the vicinity; a thorough program of chloride sampling on wells within a three mile distance to the west and 5 miles to the east should be conducted and correlated with depth and bedrock elevation.


With the exception of the manganese content, which appears to be localized at this well; the general area is adequate to provide for the planned pumping without depletion of the ground water supply.

*O. S. Fent*  
 O. S. Fent

4 CYCLES X 10 DIVISIONS PER INCH


May 7 Pump test Rodney Voght Irrigation well - Drawdown in pump well  $Q = 725 \text{ gpm}$

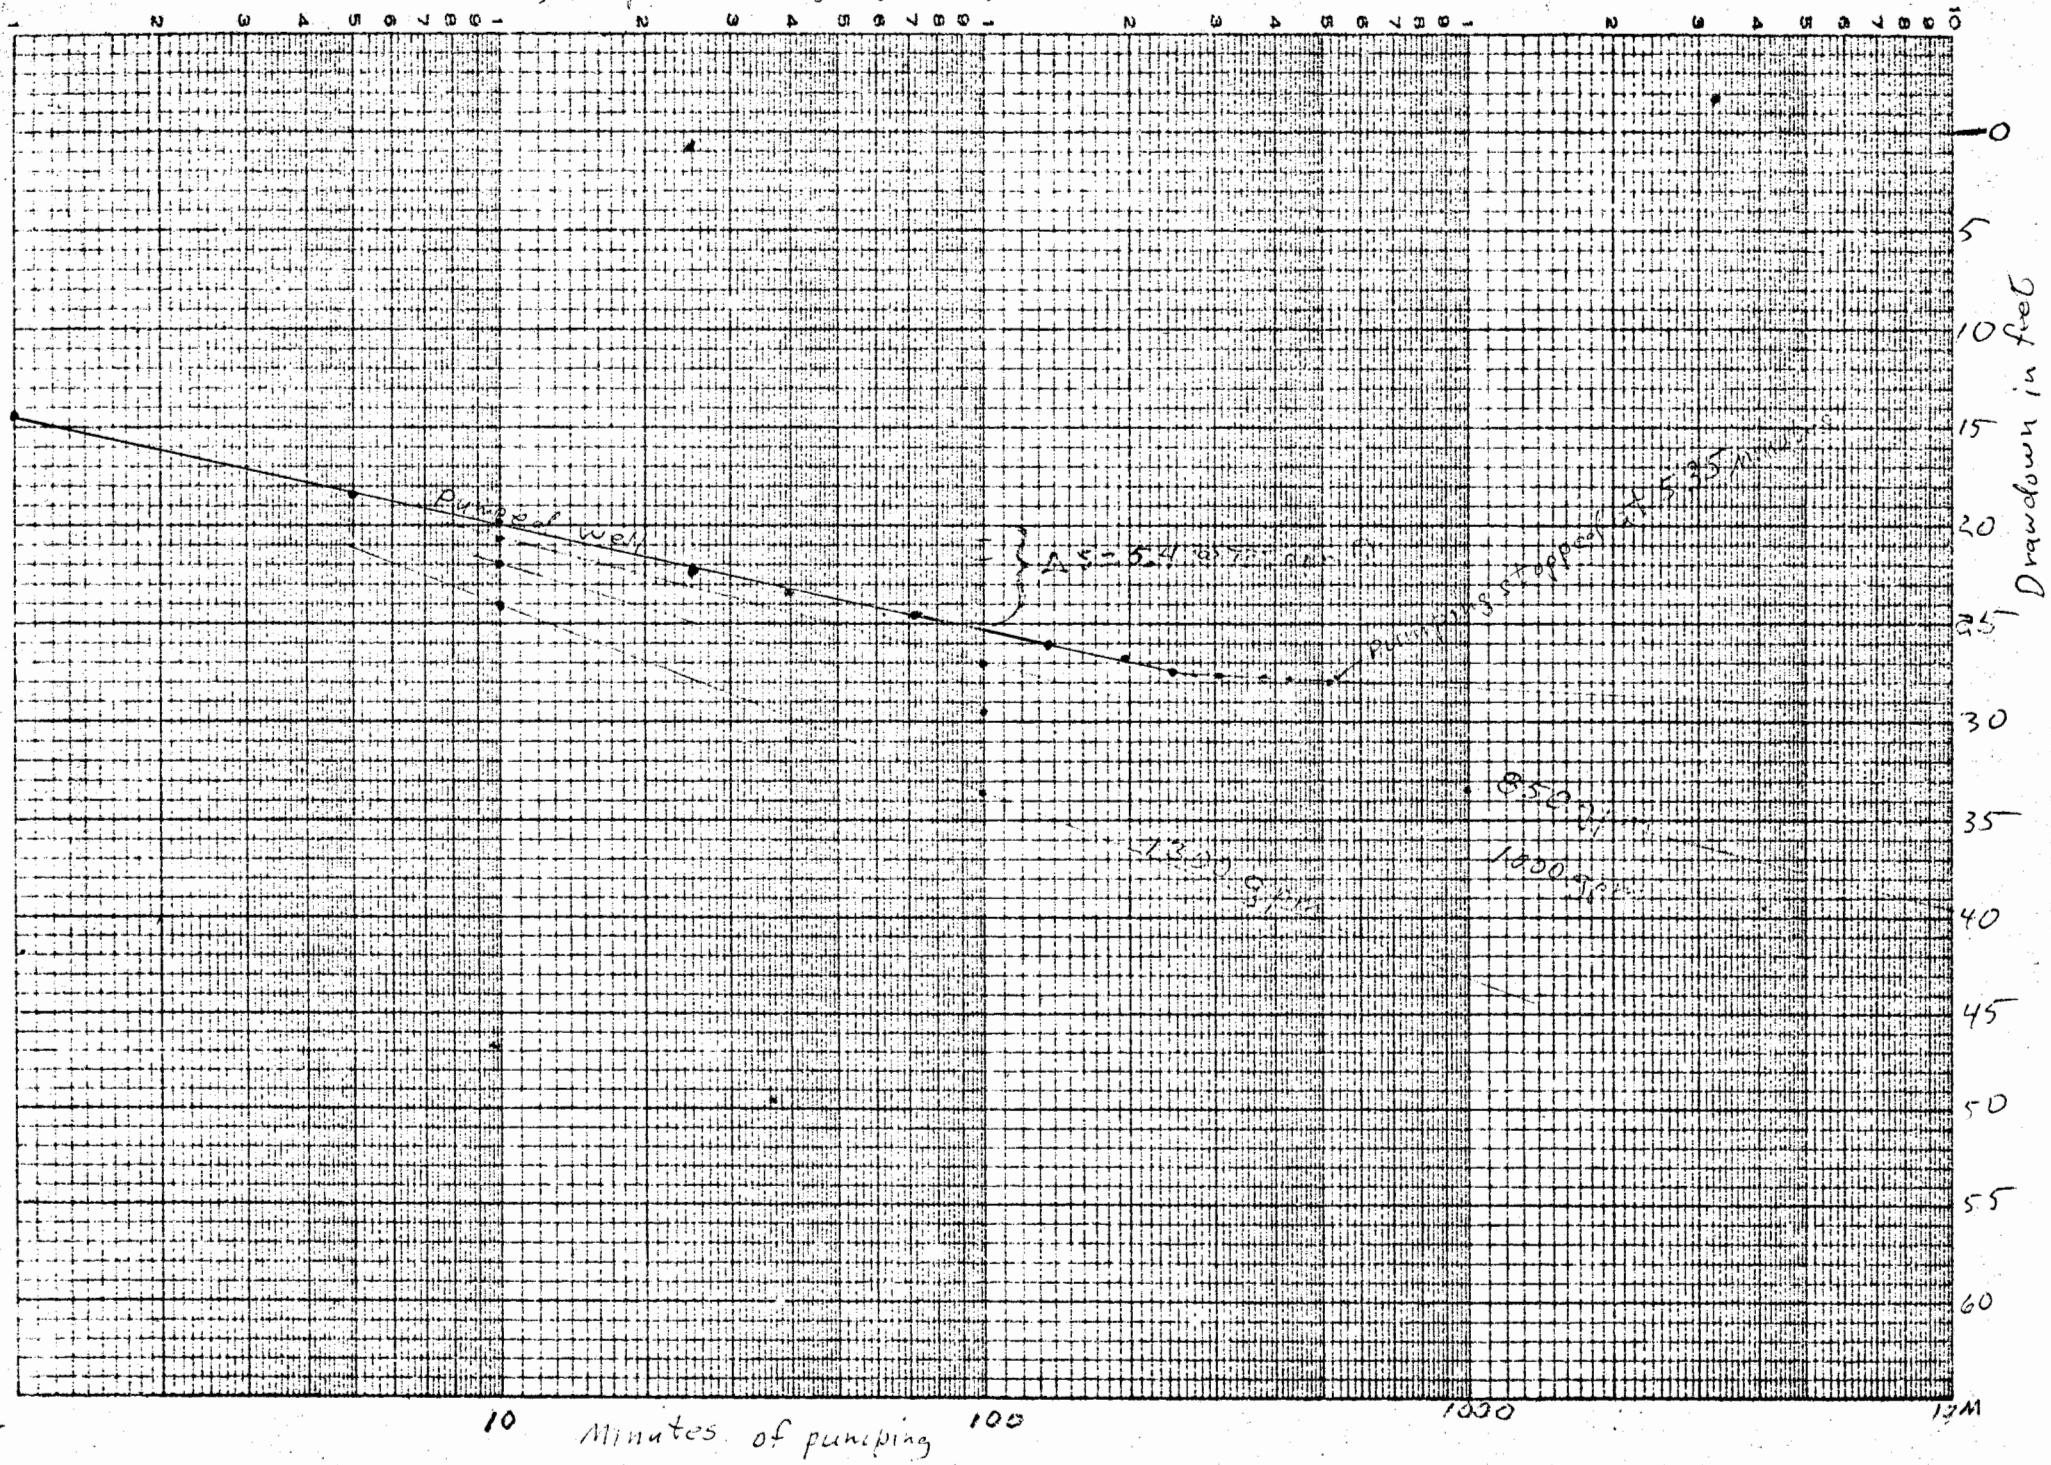


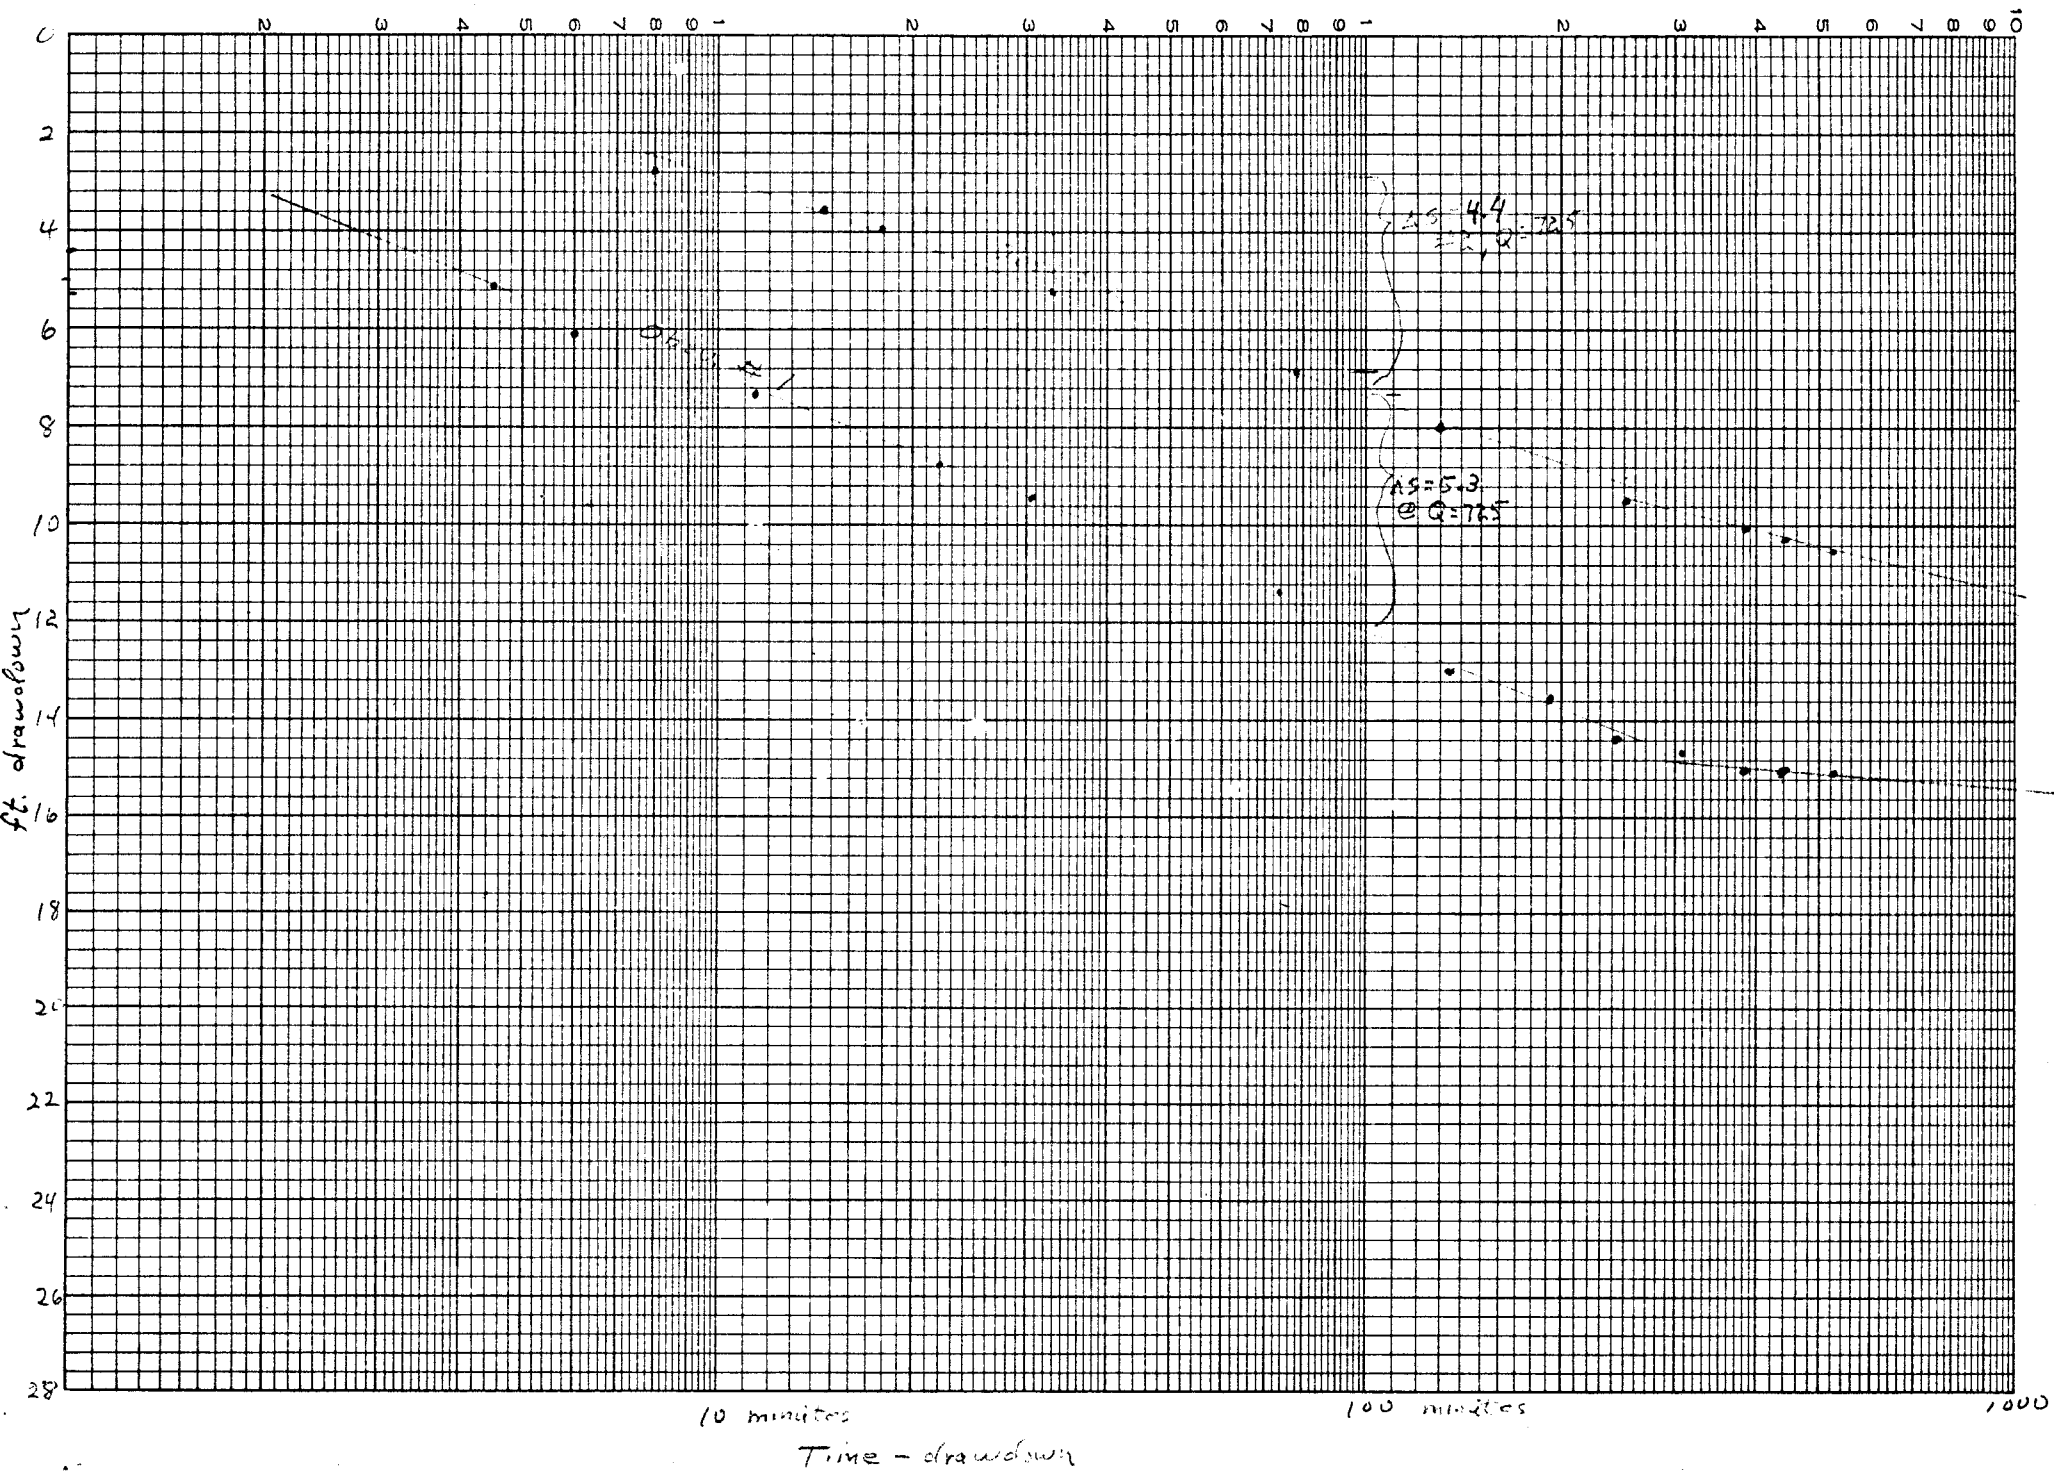



Recovering

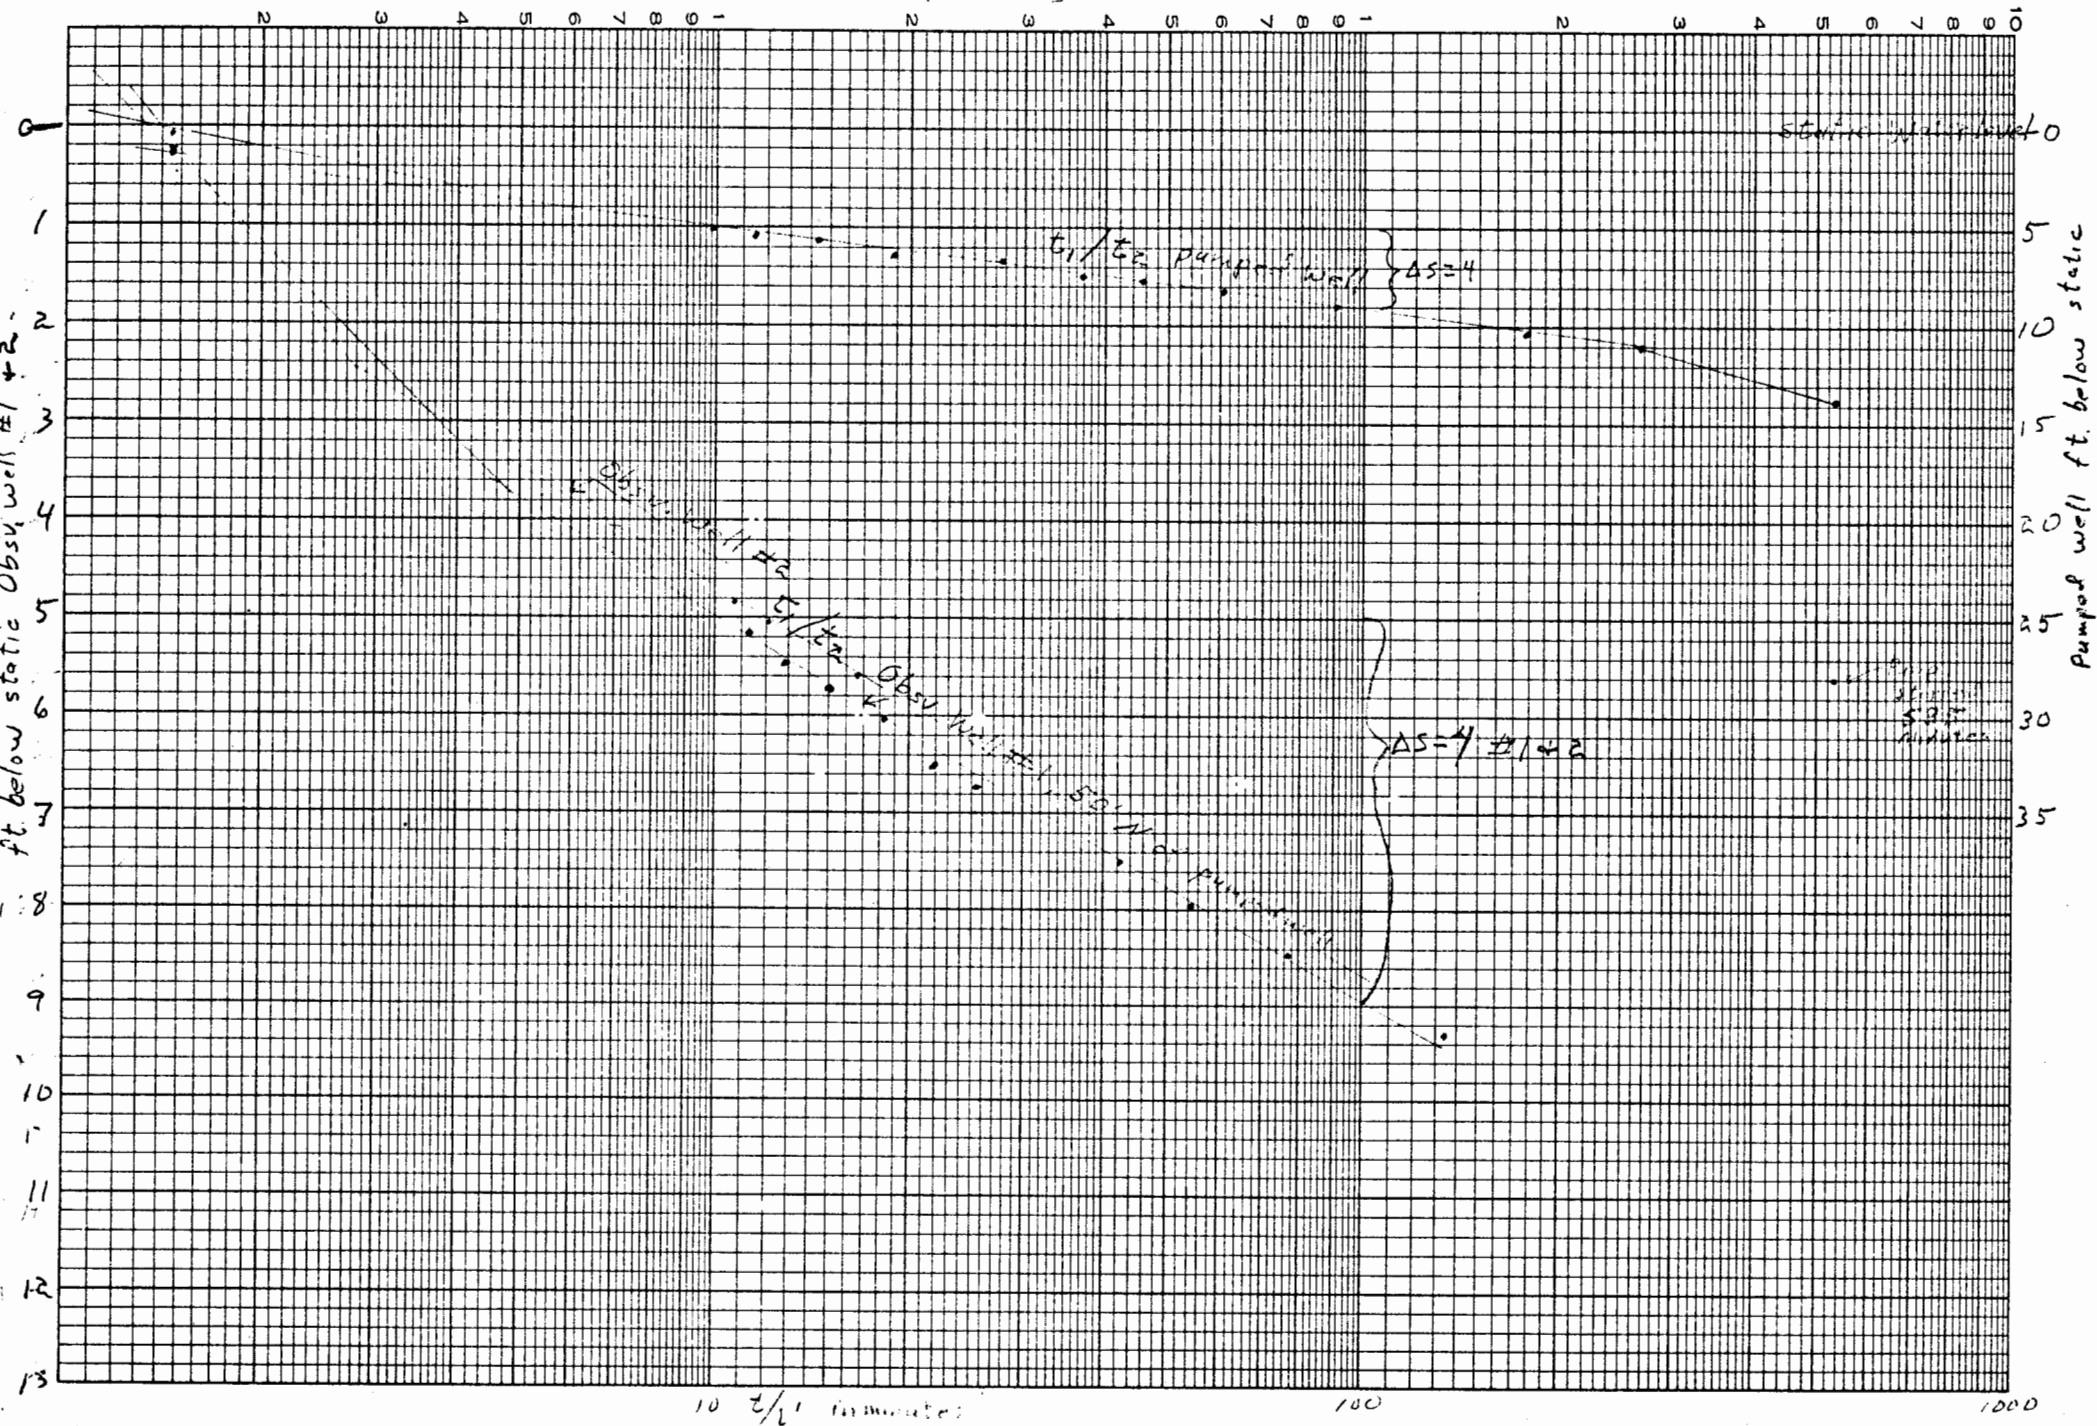

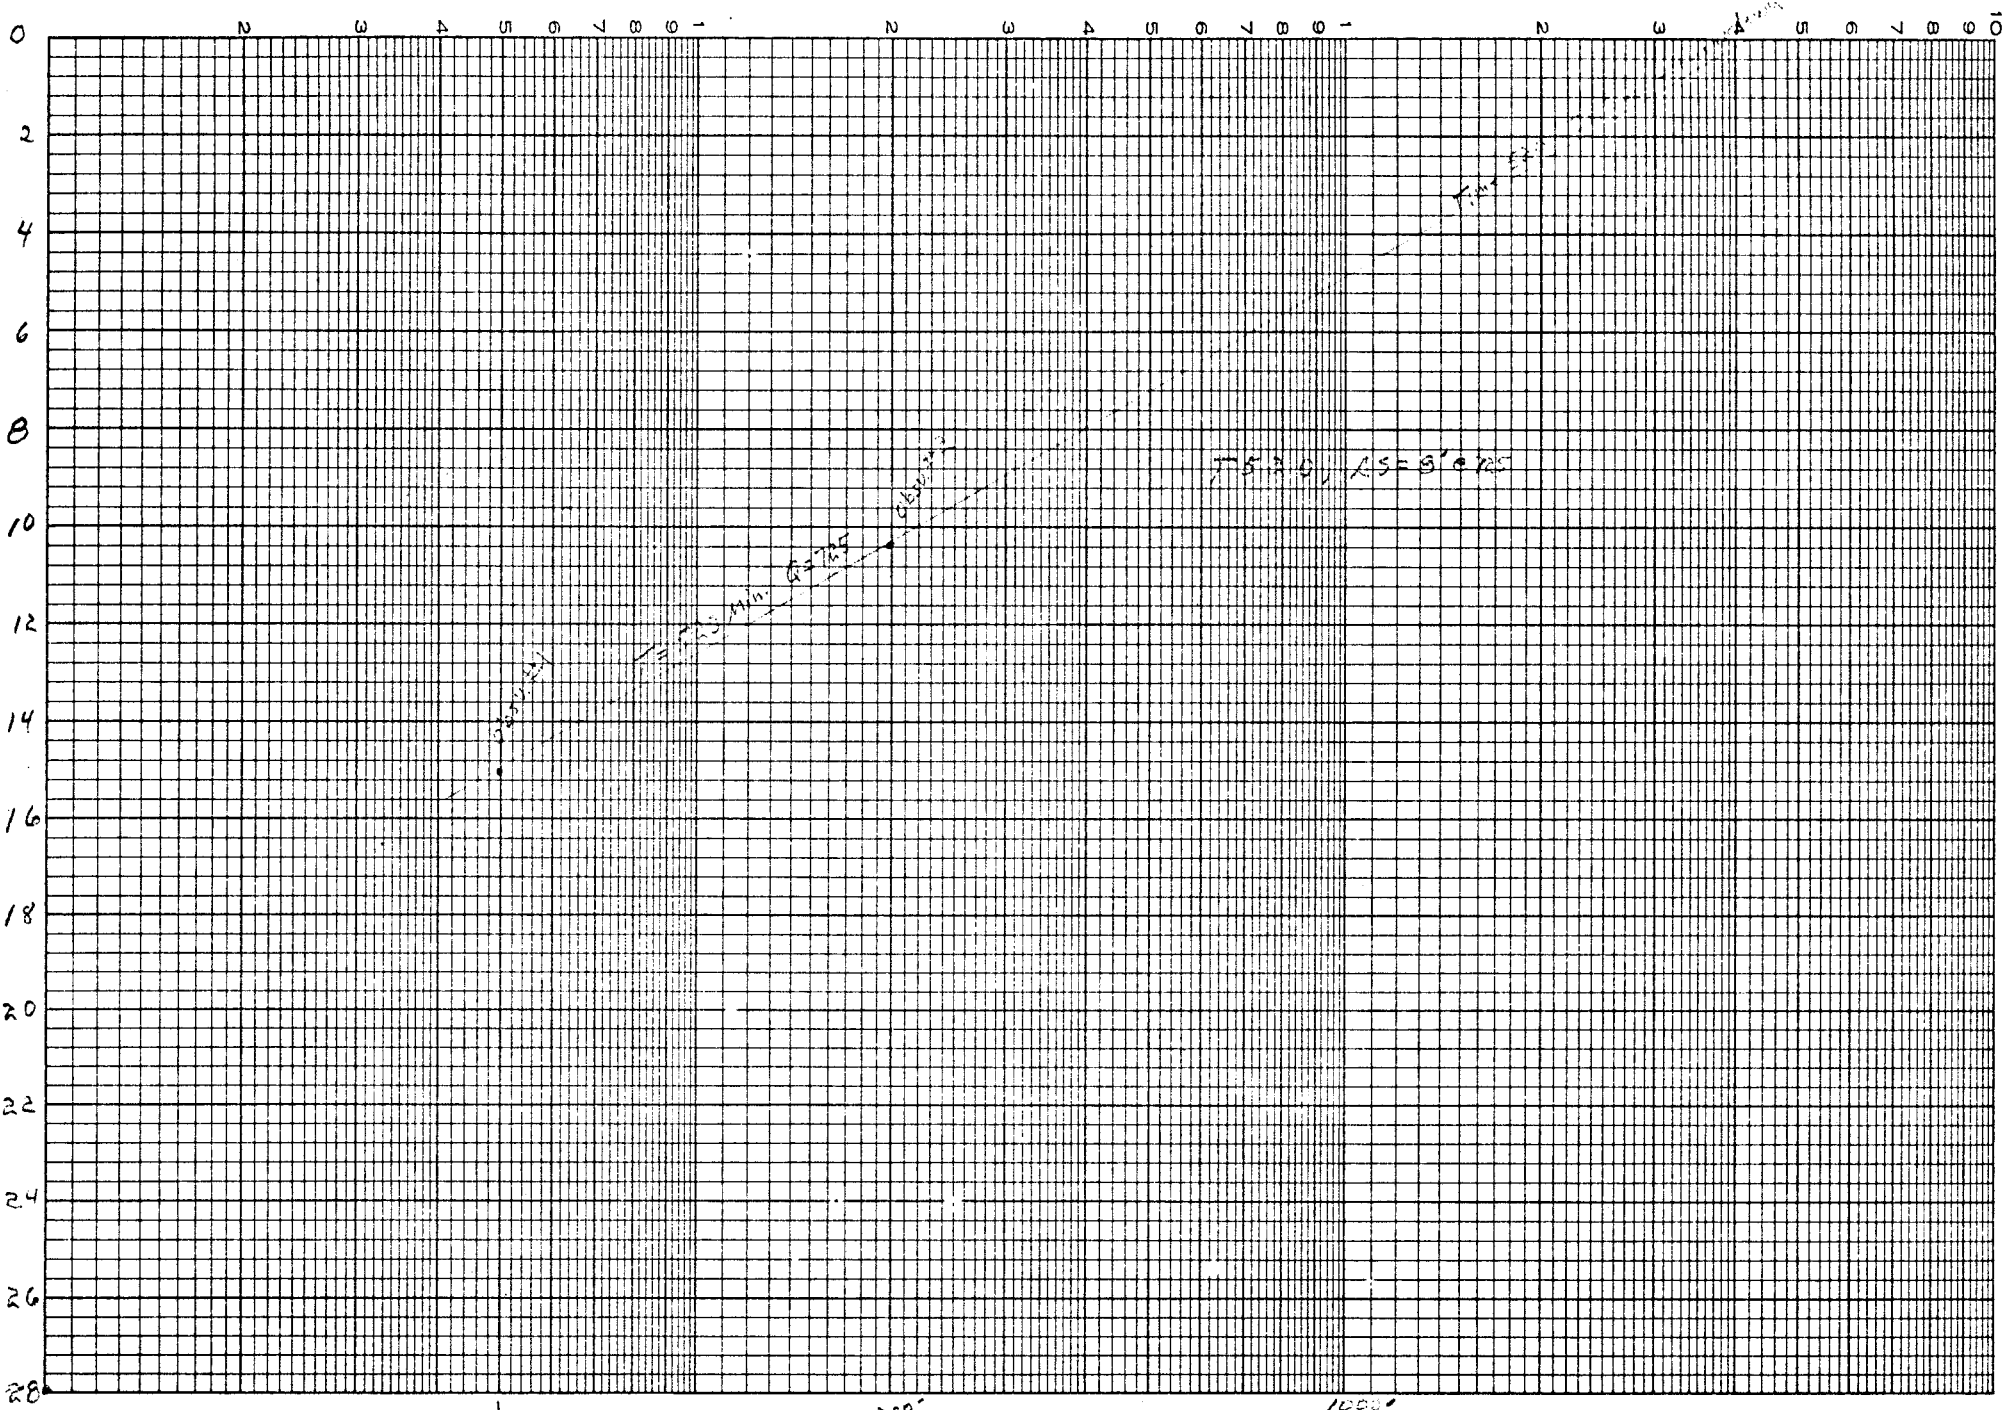

Well efficiency - 73%

Distance - drawdown



## HYDRAULIC DRILLING COMPANY

ROUTE 2 - BOX 202 A  
SALINA, KANSAS 67401

May 13, 1976

Logs of observation wells drilled for pumping tests on Rodney Voght irrigation well in the NW<sub>4</sub> Sec. 9, T.20S., R.1W., McPherson County

No. 1, 50 ft. north, 12 degrees west of pumped well.

Pleistocene and Pliocene:

|    |    |   |
|----|----|---|
| 0  | 18 | Clay, silty, sandy, tan and gray  |
| 18 | 39 | Clay, sandy, gray-green, buff and cream; contains much caliche          |
| 39 | 54 | Sand, medium to fine. (0.7 mm top size 39 to 47, 2.0 mm top size 47-54) |

|      |      |   |
|------|------|---|
| 54   | 55   | Clay, brown   |
| 55   | 62.5 | Gravel fine and sand. (range 1 to 3 mm., little to 5 mm.)                           |
| 62.5 | 69   | Clay, green; interbedded with gravel fine and sand; little gravel medium to coarse. |
| 69   | 96   | Gravel, fine to coarse and sand. (range 2-5 mm, some to 8mm)                        |

Wellington shale:

|    |    |   |
|----|----|---|
| 96 | 98 | Shale, brittle, thin bedded, gray-green; contains calcite seams |
|----|----|---|

Cased with 2-inch PVC, lower 20 ft. perforated, gravel-packed, air-lift pumped at 10 gallons per minute. Water sample less than 30 ppm chloride. Casing pulled and hole plugged and filled after pump test on irrigation well. Static water level 35.03 ft. below top of casing 1.4 ft. above land surface.

No. 2, 200 ft. north-5 degrees west of pumped well.

Pleistocene and Pliocene:

|      |      |  |
|------|------|--|
| 0    | 14   | Clay, sandy, gray and brown  |
| 14   | 26   | Clay, sandy, light gray-green, white and buff; contains some caliche |
| 26   | 27.5 | Sand, coarse to fine (top size 0.7 mm)                               |
| 27.5 | 29.5 | Clay, sandy, tan; hard caliche 29-29.5                               |

|      |    |   |
|------|----|---|
| 29.5 | 55 | Sand coarse to fine (top size 1 mm) hard caliche 49 to 50.  |
| 55   | 70 | Gravel medium to fine and sand (top 20% 2-4 mm, little to 10mm)<br>Green weathered shale fragments throughout |
| 70   | 88 | Gravel, fine to coarse and sand (top 5% above 15 mm) many weathered shale fragments.                          |
| 88   | 92 | Clay, sandy, gray-brown   |

Wellington shale:

|    |    |   |
|----|----|---|
| 92 | 93 | Shale, brittle, green with calcite seam fillings. |
|----|----|---|

Cased to 93 ft. with 2-inch PVC, lower 20 ft. perforated, gravel-packed, air-lift pumped at 10 gallons per minute. Water sample less than 30 ppm chloride. Static water level 32.65 ft. below top of casing which is 1.5 ft. above land surface. Casing pulled, hole filled and plugged after pumping test on irrigation well.