

WATER WELL PLUGGING RECORD Form WWC-5P

KSA 82a-1212

ID NO.

29601

1 LOCATION OF WATER WELL: County: McPherson	Fraction $\frac{1}{4}$ SW $\frac{1}{4}$ SW $\frac{1}{4}$ SE $\frac{1}{4}$	Section Number 15	Township Number T 20 S	Range Number 1 <input type="checkbox"/> E <input checked="" type="checkbox"/> W
--	--	-----------------------------	----------------------------------	---

Street/Rural Address of Well Location; if unknown, distance & direction from nearest town or intersection: If at owner's address, check here ☐ Approximately 5 miles south and 0.5

miles east of Canton, KS

Global Positioning Systems (GPS) information:

Latitude: **38.30593** (in decimal degrees)

Longitude: **-97.41648** (in decimal degrees)

Elevation:

Datum: ☐ WGS84, ☐ NAD83, ☒ NAD27

Collection Method:


☒ GPS unit (Make/Model: **Garmin GPSmap 60CSx**)

☐ Digital Map/Photo, ☐ Topographic Map, ☐ Land Survey

Est. Accuracy: ☐ < 3 m, ☒ 3-5 m, ☐ 5-15 m, ☐ > 15 m

2 WATER WELL OWNER: **Jewell M Vogts Rev Trust**
RR#, St. Address, Box #: **2764 Dakota Road**
City, State ZIP Code: **Canton, KS 67428**

3 MARK WELL'S LOCATION WITH AN "X" IN SECTION BOX:

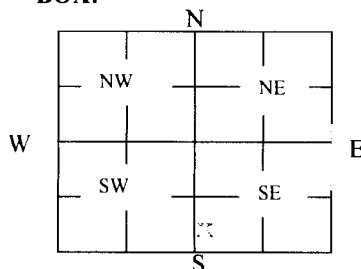

4 DEPTH OF WELL **62** ft.

WELL'S STATIC WATER LEVEL **15** ft

WELL WAS USED AS:

☐ Domestic
☒ Irrigation
☐ Feedlot
☐ Industrial

☐ Public Water Supply
☐ Oil Field Water Supply
☐ Domestic (Lawn & Garden)
☐ Air Conditioning

☐ Dewatering
☐ Monitoring
☐ Injection Well
☐ Other

Was a chemical/bacteriological sample submitted to Department? Yes ☐ No ☒

5 TYPE OF BLANK CASING USED:

☐ Steel
☐ PVC

☐ RMP (SR)
☐ ABS

☐ Wrought
☐ Asbestos-Cement

☐ Fiberglass
☒ Concrete Tile

☐ Other (Specify below)

Blank casing diameter **17** in. Was casing pulled? Yes ☐ No ☒ If yes, how much
Casing height above or below land surface **below 36** in.

6 GROUT PLUG MATERIAL: ☐ Neat cement ☒ Cement grout ☐ Bentonite ☐ Other

Grout Plug Intervals: From **15** ft. to **3** ft., From _____ ft. to _____ ft., From _____ to _____ ft.

What is the nearest source of possible contamination:

☐ Septic tank
☐ Sewer lines
☐ Watertight sewer lines
☐ Lateral lines
☐ Cess pool

☐ Seepage pit
☐ Pit privy
☐ Sewage lagoon
☐ Feedyard
☐ Livestock pens

☐ Fuel Storage
☐ Fertilizer storage
☐ Insecticide storage
☐ Abandoned water well
☐ Oil well/Gas well

☒ Other (specify below)
Tailwater Pit

Direction from well? **South**
How many feet? **370** feet

FROM	TO	PLUGGING MATERIALS	FROM	TO	PLUGGING MATERIALS
62	15	Clean, coarse sand			Well plugging witnessed by
15	3	Cement grout			D. Randolph, GMD2 staff, on
3	0	Topsoil			10-25-2013

7 CONTRACTOR'S OR LANDOWNER'S CERTIFICATION: This water well was plugged under my jurisdiction and was completed on (mo/day/year) **10-25-2013** and this record is true to the best of my knowledge and belief. Kansas Water Well Contractor's License No. _____ This Water Well Record was completed on (mo/day/year) **10-29-2013** under the business name of **Jewell M Vogts Rev Trust** by (signature) **George M. Vogts**

INSTRUCTIONS: Use typewriter or ballpoint pen. Please press firmly and print clearly. Please fill in blanks, underline or circle the correct answers. Send one copy to Kansas Department of Health and Environment, Bureau of Water, Geology Section, 1000 SW Jackson St., Ste. 420, Topeka, Kansas 66612-1367. Telephone: 785/296-5524. Send one to Water Well Owner and return one for your records. Visit us at <http://www.kdheks.gov/waterwell/index.html>.

NOV 07 2013