


1 LOCATION OF WATER WELL: County: Rice	Fraction NW 1/4 SE 1/4 SW 1/4	Section Number 11	Township Number T 20 S	Range Number R 10 E/W
---	----------------------------------	----------------------	---------------------------	--------------------------

Distance and direction from nearest town or city street address of well if located within city?
 Approximately 3 miles north and 3/4 mile east of Raymond

2 WATER WELL OWNER: Clyde Ricker
 RR#, St. Address, Box #: 565 Ave. N
 City, State, ZIP Code: Raymond, KS 67573
 Board of Agriculture, Division of Water Resources
 Application Number: 42,036

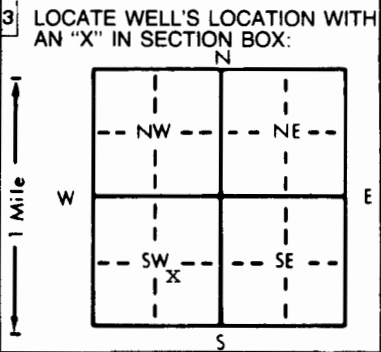

4 DEPTH OF COMPLETED WELL: 135 ft. ELEVATION: Unknown

Depth(s) Groundwater Encountered 1. ft. 2. ft. 3. ft.

WELL'S STATIC WATER LEVEL . . . 15 . . . ft. below land surface measured on mo/day/yr . . . 5-17-96

Pump test data: Well water was not ch'd ft. after hours pumping gpm

Est. Yield unknown gpm: Well water was ft. after hours pumping gpm

Bore Hole Diameter . . . 18 . . . in. to . . . 134 . . . ft., and in. to ft.

WELL WATER TO BE USED AS:

5 Public water supply	8 Air conditioning	11 Injection well
1 Domestic	3 Feedlot	6 Oil field water supply
2 Irrigation	4 Industrial	7 Lawn and garden only
		9 Dewatering
		10 Monitoring well
		12 Other (Specify below)

Was a chemical/bacteriological sample submitted to Department? Yes No If yes, mo/day/yr sample was submitted

Water Well Disinfected? Yes No

5 TYPE OF BLANK CASING USED:

1 Steel	3 RMP (SR)	5 Wrought iron	8 Concrete tile	CASING JOINTS: Glued <input checked="" type="checkbox"/> Clamped
2 PVC	4 ABS	6 Asbestos-Cement	9 Other (specify below)	Welded
		7 Fiberglass		Threaded

Blank casing diameter 10 . . . in. to . . . 94 . . . ft., Dia in. to ft., Dia in. to ft.

Casing height above land surface 12 . . . in., weight . . . 7.80 . . . lbs./ft. Wall thickness or gauge No. . . 365

TYPE OF SCREEN OR PERFORATION MATERIAL:

1 Steel	3 Stainless steel	5 Fiberglass	8 RMP (SR)	10 Asbestos-cement	11 Other (specify)
2 Brass	4 Galvanized steel	6 Concrete tile	9 ABS	12 None used (open hole)	

SCREEN OR PERFORATION OPENINGS ARE:

1 Continuous slot	3 Mill slot	5 Gauzed wrapped	8 Saw cut	11 None (open hole)
2 Louvered shutter	4 Key punched	6 Wire wrapped	9 Drilled holes	
		7 Torch cut	10 Other (specify)	

SCREEN-PERFORATED INTERVALS: From 94 . . . ft. to . . . 134 . . . ft., From ft. to ft.

GRAVEL PACK INTERVALS: From 20 . . . ft. to . . . 134 . . . ft., From ft. to ft.

6 GROUT MATERIAL: 1 Neat cement 2 Cement grout 3 Bentonite 4 Other Bentonite Holeplug

Grout Intervals: From ft. to ft., From ft. to ft., From . . . 0 . . . ft. to . . . 20 . . . ft.

What is the nearest source of possible contamination:

1 Septic tank	4 Lateral lines	7 Pit privy	10 Livestock pens	14 Abandoned water well
2 Sewer lines	5 Cess pool	8 Sewage lagoon	11 Fuel storage	15 Oil well/Gas well
3 Watertight sewer lines	6 Seepage pit	9 Feedyard	12 Fertilizer storage	16 Other (specify below)
			13 Insecticide storage	None known

Direction from well? How many feet?

FROM	TO	LITHOLOGIC LOG	FROM	TO	PLUGGING INTERVALS
0	4	Topsoil			
4	15	Clay, brown			
15	23	Sand, fine			
23	40	Clay, brown			
40	46	Sand, fine			
46	55	Clay, brown			
55	75	Clay, brown with caliche, clay, yellow, gray			
75	93	Dakota drift with clay, yellow, gray			
93	134	Sandstone, clean, loose			
134		Shale, hard			

7 CONTRACTOR'S OR LANDOWNER'S CERTIFICATION: This water well was (1) constructed, (2) reconstructed, or (3) plugged under my jurisdiction and was completed on (mo/day/year) 5-17-96 and this record is true to the best of my knowledge and belief. Kansas Water Well Contractor's License No. . . . 185 This Water Well Record was completed on (mo/day/yr) . . . 6-3-96 under the business name of Clarke Well & Equipment, Inc. by (signature) *Clarke Well & Equipment*