


<b>1 LOCATION OF WATER WELL:</b> County: <u>Rice</u>	Fraction <u>1/4 SE 1/4 SW 1/4 SE 1/4</u>	Section Number <u>2</u>	Township No. T <u>20</u> S	Range Number R <u>10</u> <input type="checkbox"/> E <input checked="" type="checkbox"/> W
Street/Rural Address of Well Location; if unknown, distance & direction from nearest town or intersection: If at owner's address, check here <input type="checkbox"/> Approximately 1 1/2 miles south and 2 1/4 miles west of Chase		<b>Global Positioning System (GPS) information:</b> Latitude: <u>38.33328</u> (in decimal degrees) Longitude: <u>-98.392849</u> (in decimal degrees) Elevation: <u>unknown</u> Datum: <input type="checkbox"/> WGS 84, <input checked="" type="checkbox"/> NAD 83, <input type="checkbox"/> NAD 27 Collection Method: <input checked="" type="checkbox"/> GPS unit (Make/Model: <u>WAAS</u> ) <input type="checkbox"/> Digital Map/Photo, <input type="checkbox"/> Topographic Map, <input type="checkbox"/> Land Survey Est. Accuracy: <input type="checkbox"/> <3 m, <input checked="" type="checkbox"/> 3-5 m, <input type="checkbox"/> 5-15 m, <input type="checkbox"/> >15 m		

**2 WATER WELL OWNER:** Clyde Ricker  
 RR#, Street Address, Box #: 565 Ave. N  
 City, State, ZIP Code : Raymond, KS 67573

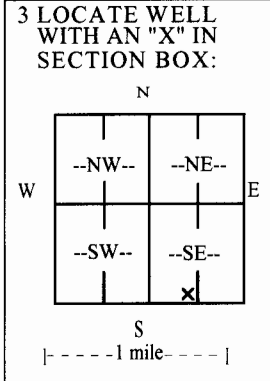

**4 DEPTH OF COMPLETED WELL** 70 ft.  
 Depth(s) Groundwater Encountered (1) 12.75 ft. (2)          ft. (3)          ft.  
 WELL'S STATIC WATER LEVEL 12.75 ft. below land surface measured on mo/day/yr 7/19/10  
 Pump test data: Well water was not checked ft. after          hours pumping          gpm  
 EST. YIELD unknown gpm. Well water was          ft. after          hours pumping          gpm  
 Bore Hole Diameter 11 in. to 76 ft., and          in. to          ft.  
 WELL WATER TO BE USED AS:  Public water supply  Geothermal  Injection well  
 Domestic  Feedlot  Oil field water supply  Dewatering  Other (Specify below)  
 Irrigation  Industrial  Domestic-lawn & garden  Monitoring well  
 Was a chemical/bacteriological sample submitted to Department?  Yes  No  
 If yes, mo/day/yr sample was submitted           
 Water well disinfected?  Yes  No

**5 TYPE OF CASING USED:**  Steel  PVC  Other  
 CASING JOINTS:  Glued  Clamped  Welded  Threaded  
 Casing diameter 5 in. to 38 ft., Diameter          in. to          ft., Diameter          in. to          ft.  
 Casing height above land surface 24 in., Weight 2.36 lbs./ft., Wall thickness or gauge No. 214  
 TYPE OF SCREEN OR PERFORATION MATERIAL:  
 Steel  Stainless Steel  PVC  Other (Specify)           
 Brass  Galvanized Steel  None used (open hole)  
 SCREEN OR PERFORATION OPENINGS ARE:  
 Continuous slot  Mill slot  Gauze wrapped  Torch cut  Drilled holes  None (open hole)  
 Louvered shutter  Key punched  Wire wrapped  Saw cut  Other (specify)           
 SCREEN-PERFORATED INTERVALS: From 38 ft. to 68 ft., From          ft. to          ft.  
 From          ft. to          ft., From          ft. to          ft.  
 GRAVEL PACK INTERVALS: From 25 ft. to 76 ft., From          ft. to          ft.  
 From          ft. to          ft., From          ft. to          ft.

**6 GROUT MATERIAL:**  Neat cement  Cement grout  Bentonite  Other Compacted Soil  
 Grout Intervals: From 5 ft. to 25 ft., From          ft. to          ft., From 0 ft. to 5 ft.  
 What is the nearest source of possible contamination:  
 Septic tank  Lateral lines  Pit privy  Livestock pens  Insecticide storage  Other (specify below)  
 Sewer lines  Cesspool  Sewage lagoon  Fuel storage  Abandoned water well  
 Watertight sewer lines  Seepage pit  Feedyard  Fertilizer storage  Oil well/gas well None known  
 Direction from well          Distance from well         

FROM	TO	LITHOLOGIC LOG	FROM	TO	LITHO. LOG (cont.) or PLUGGING INTERVALS
0	4	Topsoil			mix
4	9	Clay, light gray, soft	72	76	Clay, brown, hard with clay, white
9	14	Clay, brown, sandy			
14	19	Sand, coarse to fine with clay, brown, 50/50 mix			
19	21	Clay, light gray, soft			
21	23	Sand, medium to fine, loose, clean			
23	24	Clay, light gray, hard			
24	31	Clay, brown			
31	72	Clay, light gray with sand streaks, 50/50			

**7 CONTRACTOR'S OR LANDOWNER'S CERTIFICATION:** This water well was  constructed,  reconstructed, or  plugged under my jurisdiction and was completed on (mo/day/year) 7/19/10 and this record is true to the best of my knowledge and belief.  
 Kansas Water Well Contractor's License No. 185 This Water Well Record was completed on (mo/day/year) 7/28/10  
 under the business name of Clarke Well & Equipment, Inc. by (signature) [Signature]

INSTRUCTIONS: Use typewriter or ball point pen. **PLEASE PRESS FIRMLY** and **PRINT** clearly. Please fill in blanks and check the correct answers. Send three copies (white, blue, pink) to Kansas Department of Health and Environment, Bureau of Water, Geology Section, 1000 SW Jackson St., Suite 420, Topeka, Kansas 66612-1367. Telephone 785-296-5522. Send one copy to WATER WELL OWNER and retain one for your records. Include fee of \$5.00 for each constructed well. Visit us at <http://www.kdheks.gov/waterwell/index.html>.