


RINGWALD B-1

1 LOCATION OF WATER WELL:	Fraction	Section Number	Township Number	Range Number
County: RICE	EN 1/4 SW 1/4 NW 1/4	5	T 20 S	R 10 E

Distance and direction from nearest town or city street address of well if located within city?
CHASE 1/4 - 6W - 1/4 S EASTSIDE

2 WATER WELL OWNER:	W. RINGWALD, CHASE ILLS.
RR#, St. Address, Box #:	BOX 506
City, State, ZIP Code:	RUSSELL, KS 67665
	Board of Agriculture, Division of Water Resources
	Application Number: T85-033

3 LOCATE WELL'S LOCATION WITH AN "X" IN SECTION BOX:

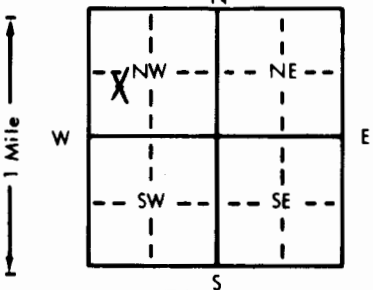

4 DEPTH OF COMPLETED WELL:	105	ft.	ELEVATION:	
Depth(s) Groundwater Encountered	1. 7.8	ft.	2.	
WELL'S STATIC WATER LEVEL	17	ft. below land surface measured on	mo/day/yr	1-3-85
Pump test data: Well water was		ft. after	hours pumping	gpm
Est. Yield		gpm: Well water was	ft. after	hours pumping
Bore Hole Diameter	7.18	in. to	105	ft., and
WELL WATER TO BE USED AS:	5 Public water supply	8 Air conditioning	11 Injection well	
	1 Domestic	3 Feedlot	6 Oil field water supply	9 Dewatering
	2 Irrigation	4 Industrial	7 Lawn and garden only	10 Observation well
Was a chemical/bacteriological sample submitted to Department?	Yes	No	If yes, mo/day/yr sample was submitted	
Water Well Disinfected?	Yes	No		

5 TYPE OF BLANK CASING USED:	5 Wrought iron	8 Concrete tile	CASING JOINTS: Glued X	Clamped
1 Steel	3 RMP (SR)	6 Asbestos-Cement	9 Other (specify below)	Welded
2 PVC	4 ABS	7 Fiberglass		Threaded

Blank casing diameter: 6 in. to 8.5 ft., Dia. in. to ft., Dia. in. to ft.
Casing height above land surface: 12 in., weight: 2.65 lbs./ft. Wall thickness or gauge No. 2.14

TYPE OF SCREEN OR PERFORATION MATERIAL:	7 PVC	10 Asbestos-cement
1 Steel	3 Stainless steel	5 Fiberglass
2 Brass	4 Galvanized steel	6 Concrete tile
	8 RMP (SR)	11 Other (specify)
	9 ABS	12 None used (open hole)

SCREEN OR PERFORATION OPENINGS ARE: 1/8	5 Gauzed wrapped	8 Saw cut	11 None (open hole)
1 Continuous slot	3 Mill slot	6 Wire wrapped	9 Drilled holes
2 Louvered shutter	4 Key punched	7 Torch cut	10 Other (specify)

SCREEN-PERFORATED INTERVALS:	From 85 ft. to 105 ft., From ft. to ft.
GRAVEL PACK INTERVALS:	From 75 ft. to 105 ft., From ft. to ft.

6 GROUT MATERIAL:	1 Neat cement	2 Cement grout	3 Bentonite	4 Other
Grout intervals:	From 0 ft. to 10 ft., From ft. to ft., From ft. to ft.			

What is the nearest source of possible contamination: NONE	10 Livestock pens	14 Abandoned water well
1 Septic tank	4 Lateral lines	7 Pit privy
2 Sewer lines	5 Cess pool	8 Sewage lagoon
3 Watertight sewer lines	6 Seepage pit	9 Feedyard
	11 Fuel storage	15 Oil well/Gas well
	12 Fertilizer storage	16 Other (specify below)
	13 Insecticide storage	

Direction from well? How many feet?

FROM	TO	LITHOLOGIC LOG	FROM	TO	LITHOLOGIC LOG
0	4	TOP SOIL			
4	15	CLAY			
15	30	CLAY + SANDROCK			
30	45	CLAY			
45	50	CLAY + FINE SAND			
50	73	CLAY			
73	105	SANDROCK			

7 CONTRACTOR'S OR LANDOWNER'S CERTIFICATION: This water well was (1) constructed, (2) reconstructed, or (3) plugged under my jurisdiction and was completed on (mo/day/year) 1-3-85 and this record is true to the best of my knowledge and belief. Kansas Water Well Contractor's License No. 389 This Water Well Record was completed on (mo/day/yr) 1-10-85 under the business name of REISER WATER WELL SERVICE (signature) Paul R. Reiser
--

INSTRUCTIONS: Use typewriter or ball point pen, PLEASE PRESS FIRMLY and PRINT clearly. Please fill in blanks, underline or circle the correct answers. Send top three copies to Kansas Department of Health and Environment, Division of Environment, Environmental Geology Section, Topeka, KS 66620. Send one to WATER WELL OWNER and retain one for your records.

OFFICE USE ONLY
T
R
EW
SEC.