USE TYPEWRITER OR BALL POINT PEN-PRESS FIRMLY, PRINT CLEARLY.

WATER WELL RECORD
KSA 82a-1201-1215

Kansas Department of Health and Environment-Division of Environment
(Water well Contractors)
Topeka, Kansas 66620

1. Location of well:	County	Fraction	Section number	Township number	Range number
	Rice	1/4 CNW 1/4 SW 1/4	15	T 20 S	R 10W E/W

2. Distance and direction from nearest town or city:
Street address of well location if in city: 2n Raymond, Ks.

3. Owner of well: Verbal Burns
R.R. or street: R1 Raymond, Ks.
City, state, zip code:

4. Locate with "X" in section below:

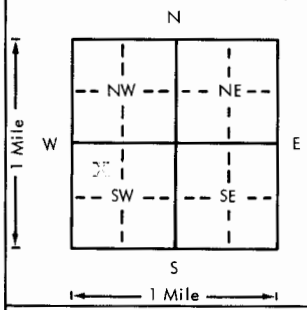

Sketch map:

6. Bore hole dia. 8 in. Completion date
Well depth 110 ft. 4-11-78

7. __ Cable tool X Rotary __ Driven __ Dug
__ Hollow rod __ Jetted __ Bored __ Reverse rotary

8. Use: X Domestic __ Public supply __ Industry
__ Irrigation __ Air conditioning __ Stock
__ Lawn __ Oil field water __ Other

9. Casing: Material
Threaded ___ Welded ___
RMP ___ PVC X
Dia. 5 in. to 110 ft. depth
Dia. ___ in. to ___ ft. depth
Height: Above ~~Below~~ Surface 12 in.
Weight 2.8 lbs./ft.
Wall Thickness: inches or gage No. Sch 40

5. Type and color of material	From	To
Top Soil-Clay	0	25
Sand	25	40
Clay	40	85
Sand Rock	85	110

(Use a second sheet if needed)

10. Screen: Manufacturer's name Jetstream
Type pvc Dia. 5"
Slot/gauze 1/32" Length 20'
Set between 90 ft. and 110 ft.
ft. and ft.
Gravel pack? X Size range of material 1/8-3/4"

11. Static water level:
32 ft. below land surface Date (mo./day/yr.) 4-11-78

12. Pumping level below land surfaces:
ft. after hrs. pumping g.p.m.
ft. after hrs. pumping g.p.m.
Estimated maximum yield 50 g.p.m.

13. Water sample submitted: (mo./day/yr.)
__ Yes X No Date

14. Well head completion:
X Pitless adapter ___ Inches above grade

15. Well grouted? X
With: X Neat cement __ Bentonite __ Concrete
Depth: From 4[redacted] ft. to [redacted]4 ft.

16. Nearest source of possible contamination:
ft. 60 Direction nw Type sewer
Well disinfected upon completion? X Yes __ No

17. Pump: X Not installed
Manufacturer's name
Model number HP Volts
Length of drop pipe ft. capacity g.p.m.
Type:
__ Submersible __ Turbine
__ Jet __ Reciprocating
__ Centrifugal __ Other

18. Elevation:

Topography:
__ Hill
__ Slope
X Upland
__ Valley

19. Remarks:

20. Water well contractor's certification:
This well was drilled under my jurisdiction and this report is true to the best of my knowledge and belief.
Kellys Waterwell Ser 186
Business name License No.
Address R2 Great Bend, Ks.
Signed Kelly Price Date 2-22-
Authorized representative

20 T 10 R (W) E 15 Sec CNW 1/4 1/4 1/4 1/4

Forward the white, blue and pink copies to the Department of Health and Environment

Form WWC-5