USE TYPEWRITER OR BALL POINT PEN-PRESS FIRMLY, PRINT CLEARLY.

WATER WELL RECORD
KSA 82a-1201-1215

Kansas Department of Health and Environment-Division of Environment
(Water well Contractors)
Topeka, Kansas 66620

Hirsch #4

1. Location of well:	County	Fraction	Section number	Township number	Range number
	Rice	NW 1/4 NW 1/4 NE 1/4	19	T 20 S	R 10 E/W

2. Distance and direction from nearest town or city: 2 north
Street address of well location if in city: 3½ West Raymond

3. Owner of well: Sterling Drilling Co
R.R. or street:
City, state, zip code: Sterling Kansas.

4. Locate with "X" in section below:

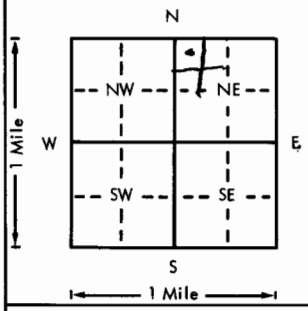

Sketch map:

6. Bore hole dia. 5 in. Completion date 9-2-75
Well depth 40 ft.

7. __ Cable tool X Rotary __ Driven __ Dug
__ Hollow rod __ Jetted __ Bored __ Reverse rotary

8. Use: __ Domestic __ Public supply __ Industry
__ Irrigation __ Air conditioning __ Stock
__ Lawn X Oil field water __ Other

9. Casing: Material PVC Height: Above or below
Threaded ___ Welded X Surface 12 in.
RMP ___ PVC X Weight 42 lbs./ft.
Dia. 2 in. to 40 ft. depth Wall Thickness: inches or
Dia. ___ in. to ___ ft. depth gage No. [redacted] 200

10. Screen: Manufacturer's name Perfless Plastic
Type PVC Dia. 2
Slot gauze 1/8 Length 10
Set between 30 ft. and 40 ft.
___ ft. and ___ ft.
Gravel pack? yes Size range of material 1/8-1/4

11. Static water level: mo./day/yr.
8 ft. below land surface Date 9-2-75

12. Pumping level below land surfaces:
___ ft. after ___ hrs. pumping ___ g.p.m.
___ ft. after ___ hrs. pumping ___ g.p.m.
Estimated maximum yield ___ g.p.m.

13. Water sample submitted: mo./day/yr.
__ Yes X No Date

14. Well head completion:
__ Pitless adapter ___ Inches above grade

15. Well grouted? yes
With: __ Neat cement X Bentonite __ Concrete
Depth: From 0 ft. to 10 ft.

16. Nearest source of possible contamination:
ft. ___ Direction ___ Type ___
Well disinfected upon completion? ___ Yes ___ No

17. Pump: X Not installed
Manufacturer's name
Model number ___ HP ___ Volts ___
Length of drop pipe ___ ft. capacity ___ g.p.m.
Type:
__ Submersible __ Turbine
__ Jet __ Reciprocating
__ Centrifugal __ Other

5. Type and color of material

	From	To
Sandy Clay	0	8
Sand	8	25
Gravel	25	40

(Use a second sheet if needed)

18. Elevation:

Topography:
__ Hill
X Slope
__ Upland
__ Valley

19. Remarks:

20. Water well contractor's certification:
This well was drilled under my jurisdiction and this report is true to the best of my knowledge and belief.
Business name Myers Water Well 143 License No.
Address Great Bend KS
Signed Alfred A Myers Date 9-2-75
Authorized representative

T 20 R 10 E Sec 19 1/4 NW 1/4 NE 1/4

Forward the white, blue and pink copies to the Department of Health and Environment

Form WWC-5