

USE TYPEWRITER OR BALL POINT PEN—PRESS FIRMLY, PRINT CLEARLY.

WATER WELL RECORD  
KSA 82a-1201-1215


T R EW sec 1/4 1/4 1/4 No.

Kansas State Dept. Of Health  
(Water Well Contractors)  
Forbes-Bldg. 740  
Topeka, Kansas 66620

*Speck #1 B*

1 Location of well:	County <i>Rice</i>	Township name	Fraction <i>NW NW 8E</i>	Section number <i>20</i>	Town number <i>20 S</i>	Range number <i>10 W</i>
---------------------	--------------------	---------------	--------------------------	--------------------------	-------------------------	--------------------------

Distance and direction from nearest town or city: <i>2 West 1 1/2 north Raymond</i>	3 Owner of well: <i>Sterling Drilling Co Sterling Kansas.</i>
Street address of well location if in city:	Address:

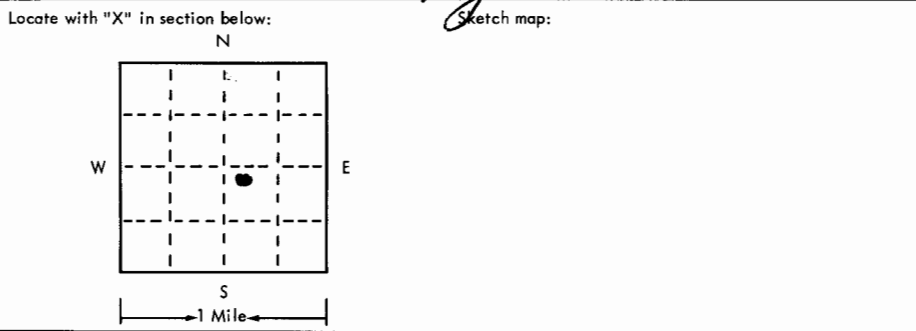

4 Well depth: *40* ft. Date of completion: *8-6-75*  
Well diameter: *8.5* in.

5  Cable tool  Rotary  Driven  Dug  
 Hollow rod  Jetted  Bored  Reverse rotary

6 Use:  Domestic  Public supply  Industry  
 Irrigation  Air conditioning  Commercial  
 Test well  *oil field supply*

7 Casing: Material: *PVC* Height:  above  below  
Threaded  Welded  Surface *1.2* in.  
Diam. \_\_\_\_\_ Weight: *40* lbs./ft. *1.0*  
*2* in. to *40* ft. depth Drive shoe?  Yes  No  
\_\_\_\_ in. to \_\_\_\_ ft. depth

2	Type and color of material	From	To
	<i>Clay</i>	<i>0</i>	<i>10</i>
	<i>Sand</i>	<i>10</i>	<i>25</i>
	<i>Gravel</i>	<i>25</i>	<i>40</i>

8 Screen: *jet stream*  
Manufacturer: *APV* Dia. *2*  
Type: \_\_\_\_\_ Slot gauge: *5/8* Length: *10*  
Set between *30* ft. and *40* ft.  
Fittings: \_\_\_\_\_ Gravel pack  Yes  No Size range of material: \_\_\_\_\_

9 Static water level: *10* ft. below land surface Date: *8-6-75*

10 Pumping level below land surfaces:  
\_\_\_\_\_ ft. after \_\_\_\_\_ hrs. pumping \_\_\_\_\_ g.p.m.  
\_\_\_\_\_ ft. after \_\_\_\_\_ hrs. pumping \_\_\_\_\_ g.p.m.  
Estimated maximum yield \_\_\_\_\_ g.p.m.

11 Water sample submitted:  
 Yes  No Date \_\_\_\_\_

12 Well head completion:  
 Pitless adapter  Inches above grade

13 Well grouted?  Yes  No  
 Neat cement  Bentonite  \_\_\_\_\_  
Depth: From *6* ft. to *10* ft.

14 Nearest source of possible contamination:  
ft. \_\_\_\_\_ Direction \_\_\_\_\_ Type \_\_\_\_\_  
Well disinfected upon completion?  Yes  No

15 Pump:  Not installed  
Manufacturer's name \_\_\_\_\_  
Model number \_\_\_\_\_ HP \_\_\_\_\_ Volts \_\_\_\_\_  
Length of drop pipe \_\_\_\_\_ ft. capacity \_\_\_\_\_ g.m.p.  
Type:  
 Submersible  Turbine  
 Jet  Reciprocating  
 Centrifugal  Other

16 Remarks: elevation

Topography:  
 Hill  
 Slope  
 Upland  
 Valley

17 Water well contractor's certification:  
This well was drilled under my jurisdiction and this report is true to the best of my knowledge and belief.  
*Myerwater 228 143*  
Business name: \_\_\_\_\_ License No. \_\_\_\_\_  
Address: *Great Bend Ks 143*  
Signed: *Armed A Myer* Date: *8-6-75*  
Authorized representative

*80 10 W 20 NW 8E*