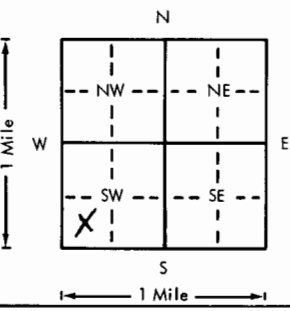


USE TYPEWRITER OR BALL POINT PEN—PRESS FIRMLY, PRINT CLEARLY.

WATER WELL RECORD
KSA 82a-1201-1215

Kansas Department of Health and Environment—Division of Environment
(Water well Contractors)
Topeka, Kansas 66620

1. Location of well:		County Rice	Fraction C 1/4 SW 1/4 SW 1/4	Section number 29	Township number T 20 S R	Range number 10 E/D
2. Distance and direction from nearest town or city: 1 N 2 1/2 W se into the field of Raymond				3. Owner of well: Terry Kowalsky R.R. or street: 2924 Quivira City, state, zip code: Great Bend, Ks. 67530		
4. Locate with "X" in section below: 				Sketch map:		6. Bore hole dia. 29 in. Completion date _____ Well depth 43.0 8-25-76
5. Type and color of material				From	To	7. <input type="checkbox"/> Cable tool <input checked="" type="checkbox"/> Rotary <input type="checkbox"/> Driven <input type="checkbox"/> Dug <input type="checkbox"/> Hollow rod <input type="checkbox"/> Jetted <input type="checkbox"/> Bored <input type="checkbox"/> Reverse rotary
Sandy Top Soil				0	2	8. Use: <input type="checkbox"/> Domestic <input type="checkbox"/> Public supply <input type="checkbox"/> Industry <input checked="" type="checkbox"/> Irrigation <input type="checkbox"/> Air conditioning <input type="checkbox"/> Stock <input type="checkbox"/> Lawn <input type="checkbox"/> Oil field water <input type="checkbox"/> Other
Fine Sand				2	4	9. Casing: Material steel Height: Above or below Threaded <input type="checkbox"/> Welded <input checked="" type="checkbox"/> Surface 18 in. RMP <input type="checkbox"/> PVC <input type="checkbox"/> Weight _____ lbs./ft. Dia. 16 in. to 40 ft. depth Wall Thickness: _____ inches or Dia. _____ in. to _____ ft. depth gage No. 7
Dark Brown Clay				4	6	10. Screen: Manufacturer's name _____ Doerrs Type steel Dia. 16 Slot/gauze 3/16 Length 6 Set between 24 ft. and 30 ft. Gravel pack? <input checked="" type="checkbox"/> Size range of material 1/2 3/4 3/8
Fine Sand and Gravel Gray Clay Mixed				6	9	11. Static water level: _____ mo./day/yr. 9 ft. below land surface Date 8-2-76
Sand & Gravel Med. loose				9	18	12. Pumping level below land surfaces: 9 ft. after 1 hrs. pumping 550 g.p.m. _____ ft. after _____ hrs. pumping _____ g.p.m. Estimated maximum yield 600 g.p.m.
Gray Sandy Clay				18	19	13. Water sample submitted: _____ mo./day/yr. <input checked="" type="checkbox"/> Yes <input type="checkbox"/> No Date 8-2-76
Sand and Gravel Coarse				19	40	14. Well head completion: <input type="checkbox"/> Pitless adapter _____ Inches above grade
(Use a second sheet if needed)						15. Well grouted? <input checked="" type="checkbox"/> With: <input type="checkbox"/> Neat cement <input type="checkbox"/> Bentonite <input checked="" type="checkbox"/> Concrete Depth: From _____ ft. to 10 ft.
						16. Nearest source of possible contamination: ft. 2 Direction NE Type correll Well disinfected upon completion? <input type="checkbox"/> Yes <input type="checkbox"/> No
						17. Pump: _____ Not installed Manufacturer's name Western Land Rodler Model number 6-CM-10 HP 40 Volts _____ Length of drop pipe 20 ft. capacity 600 g.p.m. Type: <input type="checkbox"/> Submersible <input checked="" type="checkbox"/> Turbine <input type="checkbox"/> Jet <input type="checkbox"/> Reciprocating <input type="checkbox"/> Centrifugal <input type="checkbox"/> Other
18. Elevation:	19. Remarks:		20. Water well contractor's certification: This well was drilled under my jurisdiction and this report is true to the best of my knowledge and belief. Rosencrantz-Bemis 134 Business name License No. _____ Address Great Bend, Ks. 6752 Signed Media Dobson Date 11/18/76 Authorized representative			
Topography: <input type="checkbox"/> Hill <input type="checkbox"/> Slope <input checked="" type="checkbox"/> Upland <input type="checkbox"/> Valley						

20 10 29
 Sec 29
 1/4 SW 1/4 SW