


1 LOCATION OF WATER WELL:		Fraction		Section Number		Township Number		Range Number	
County:	Barton	SW ¼ SE ¼ SW ¼		13		T 20 S		R 11	EW

2	WATER WELL OWNER:	Carl Isern	
	RR#, St. Address, Box # :	PO Box 13	Board of Agriculture, Division of Water Resources
	City, State, ZIP Code :	Ellinwood, Ks. 67526	Application Number: BTWW0493

4 DEPTH OF COMPLETED WELL..... 6.0 ft. ELEVATION:

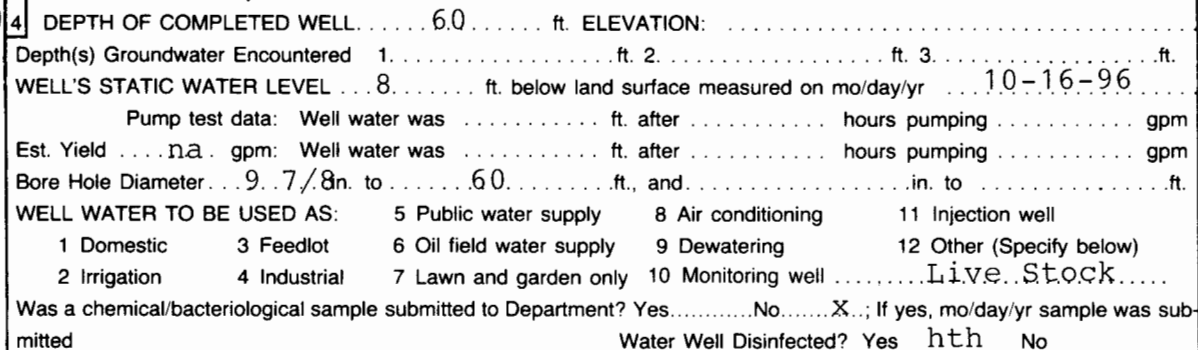

Blank casing diameter 5 in. to 52 ft., Dia in. to ft., Dia in. to ft.
Casing height above land surface 2' in., weight SDR 26 lbs./ft. Wall thickness or gauge No.

SCREEN OR PERFORATION OPENINGS ARE:		5 Gauzed wrapped	8 Saw cut	11 None (open hole)
1 Continuous slot	3 Mill slot	6 Wire wrapped	9 Drilled holes	
2 Louvered shutter	4 Key punched	7 Torch cut	10 Other (specify)	

6 GROUT MATERIAL: 1 Neat cement 2 Cement grout 3 Bentonite 4 Other hole plug
Grout Intervals: From 8 ft. to 0 ft. From ft. to ft. From ft. to ft.

What is the nearest source of possible contamination:

1 <u>Septic tank</u>	4 Lateral lines	7 Pit privy	10 Livestock pens	14 Abandoned water well
2 Sewer lines	5 Cess pool	8 Sewage lagoon	11 Fuel storage	15 Oil well/Gas well
3 Watertight sewer lines	6 Seepage pit	9 Feedyard	12 Fertilizer storage	16 Other (specify below)
Direction from well?	west		How many feet?	300'

[illegible]

7 CONTRACTOR'S OR LANDOWNER'S CERTIFICATION: This water well was (1) constructed, (2) reconstructed, or (3) plugged under my jurisdiction and was completed on (mo/day/year) 10-16-96 and this record is true to the best of my knowledge and belief. Kansas Water Well Contractor's License No. 134. This Water Well Record was completed on (mo/day/yr) 10-23-96 under the business name of Rosencrantz-Bemis by (signature) Lucie Reddon