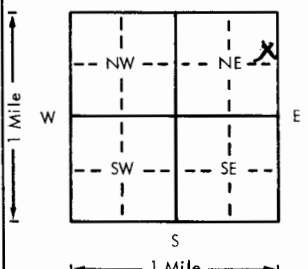


USE TYPEWRITER OR BALL
POINT PEN-PRESS FIRMLY,
PRINT CLEARLY.

WATER WELL RECORD
KSA 82a-1201-1215

Kansas Department of Health and
Environment-Division of Environment
(Water well Contractors)
Topeka, Kansas 66620

William #1

1. Location of well: BARTON		County: BARTON	Fraction: SE 1/4 NE 1/4 NE 1/4	Section number: 1	Township number: T 20	Range number: S R 11 E
2. Distance and direction from nearest town or city: 6 mi. EAST To Rice & Barton Co. line 4 mi. SOUTH				3. Owner of well: L.D. Delg R.R. or street: 915 S. Main St. City, state, zip code: Great Bend KS 67530		
4. Locate with "X" in section below:		Sketch map:		6. Bore hole dia. 9 in. Completion date 10-12-78 Well depth 30 ft.		
				7. Cable tool ☒ Rotary ☐ Driven ☐ Dug ☐ Hollow rod ☐ Jetted ☐ Bored ☐ Reverse rotary		
5. Type and color of material				8. Use: ☐ Domestic ☐ Public supply ☐ Industry ☐ Irrigation ☐ Air conditioning ☐ Stock ☐ Lawn ☒ Oil field water ☐ Other		
				9. Casing: Material ☐ Height: Above or below Threaded ☐ Welded ☒ Surface 12 in. RMP ☐ PVC ☒ Weight 278-3 lbs./ft. Dia. 5 in. to 30 ft. depth Wall thickness: inches or Dia. ☐ in. to ☐ ft. depth gage No. 200-26		
				10. Screen: Manufacturer's name Coless MS9 Type Saw Dia. 5 Slot/gauze 1/8 Length 20 Set between 30 ft. and 10 ft. Gravel pack? yes Size range of material 1/2-1/4		
				11. Static water level: 8 ft. below land surface Date 10-12-78		
				12. Pumping level below land surfaces: ____ ft. after ____ hrs. pumping ____ g.p.m. ____ ft. after ____ hrs. pumping ____ g.p.m. Estimated maximum yield ____ g.p.m.		
				13. Water sample submitted: ____ mo./day/yr. Yes ☒ No ☐ Date ____		
				14. Well head completion: ____ Pitless adapter 12 Inches above grade		
				15. Well grouted? yes With: ____ Neat cement ☒ Bentonite ____ Concrete Depth: From 0 ft. to 10 ft.		
				16. Nearest source of possible contamination ft. ____ Direction ____ Type none Well disinfected upon completion? ____ Yes ____ No		
				17. Pump: ☒ Not installed Manufacturer's name ____ Model number ____ HP ____ Volts ____ Length of drop pipe ____ ft. capacity ____ g.p.m. Type: ____ Submersible ____ Turbine ____ Jet ____ Reciprocating ____ Centrifugal ____ Other		
(Use a second sheet if needed)						
18. Elevation: Topography: ☐ Hill ☒ Slope ☐ Upland ☐ Valley		19. Remarks: 1759		20. Water well contractor's certification: This well was drilled under my jurisdiction and this report is true to the best of my knowledge and belief. Myers Water Well 143 Business name GT Bend KS License No. ____ Address 915 S. Main St. Signed Elyd Rosendahl Date 10-12-78 Authorized representative		