USE TYPEWRITER OR BALL POINT PEN-PRESS FIRMLY, PRINT CLEARLY.

T R EW sec 1/4 1/4 1/4 No.

WATER WELL RECORD
KSA 82a-1201-1215

Kansas State Dept. Of Health
(Water Well Contractors)
Forbes-Bldg. 740
Topeka, Kansas 66620

1 Location of well:	County	Township name	Fraction	Section number	Town number	Range number
	Barton	Comanche	SW¼ of NE¼	5	T20S	R11W

Distance and direction from nearest town or city: ½ mi. South of Ellinwood, Kansas

Street address of well location if in city:

3 Owner of well: LaVon Sessler

Address: Ellinwood, Kansas

Locate with "X" in section below:

Sketch map:

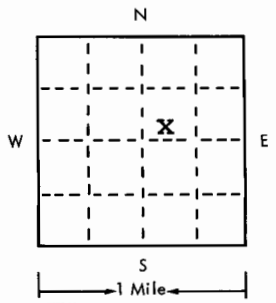

2 Type and color of material	From	To
Top soil & brown clay	0	5
Sand & gravel	5	45
Sandstone	45	46

(use a second sheet if needed)

4 Well depth: 46 ft. Date of completion 5-15-75
Well diameter 24 in.

5 ☐ Cable tool ☐ Rotary ☐ Driven ☐ Dug ☐ Hollow rod ☐ Jetted ☐ Bored ☒ Reverse rotary

6 Use: ☐ Domestic ☐ Public supply ☐ Industry ☒ Irrigation ☐ Air conditioning ☐ Commercial ☐ Test well ☐

7 Casing: Material Steel Height: above/below Surface 12 in.
Threaded ☐ Welded ☒ Weight 30.3 lbs./ft.
Diam. 16 in. to 16 ft. depth Drive shoe? ☐ Yes ☒ No
___ in. to ___ ft. depth

8 Screen:
Manufacturer W. A. Brown
Type Double-slot Dia. 16"
Slot gauze 1/8 Length 30'
Set between 16 ft. and 46 ft.
Fittings:
Gravel pack ☒ Yes ☐ No Size range of material 3/8-200

9 Static water level:
7½ ft. below land surface Date 5-15-75

10 Pumping level below land surfaces: N/C
___ ft. after ___ hrs. pumping ___ g.p.m.
___ ft. after ___ hrs. pumping ___ g.p.m.
Estimated maximum yield ___ g.p.m.

11 Water sample submitted:
☐ Yes ☒ No Date ___

12 Well head completion:
☐ Pitless adapter 12 Inches above grade

13 Well grouted? ☒ Yes ☐ No
☒ Neat cement ☐ Bentonite ☐
Depth: From 0 ft. to 10 ft.

14 Nearest source of possible contamination: NONE KNOWN
ft. ___ Direction ___ Type ___
Well disinfected upon completion? ☐ Yes ☒ No

15 Pump: ☒ Not installed
Manufacturer's name ___
Model number ___ HP ___ Volts ___
Length of drop pipe ___ ft. capacity ___ g.m.p.
Type:
☐ Submersible ☐ Turbine
☐ Jet ☐ Reciprocating
☐ Certrifugal ☐ Other

16 Remarks: elevation 1772 2 S 3 E 4 2 C 11 S WHA

Topography:
☐ Hill
☐ Slope
☐ Upland
☐ Valley

17 Water well contractor's certification:
This well was drilled under my jurisdiction and this report is true to the best of my knowledge and belief.
Business name Clarke Well & Eq., Inc. License No. 185
Address Great Bend, KS
Signed [signature] Date 5-15-75
Authorized representative