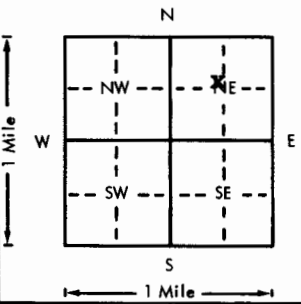


USE TYPEWRITER OR BALL
POINT PEN-PRESS FIRMLY,
PRINT CLEARLY.

WATER WELL RECORD
KSA 82a-1201-1215

Kansas Department of Health and
Environment-Division of Environment
(Water well Contractors)
Topeka, Kansas 66620

1. Location of well:		County Barton	Fraction 1/4 1/4 GNE 1/4	Section number 5	Township number T 20 S	Range number R 11 E (W)
2. Distance and direction from nearest town or city: 1/2 mile East of Ellinwood, KS Street address of well location if in city:				3. Owner of well: Charles Sessler R.R. or street: Route 2 City, state, zip code: Ellinwood, KS 67526		
4. Locate with "X" in section below:		Sketch map:		6. Bore hole dia. 24 in. Completion date 5-18-76 Well depth 48 ft.		
				7. ☐ Cable tool ☐ Rotary ☐ Driven ☐ Dug ☐ Hollow rod ☐ Jetted ☐ Bored ☒ Reverse rotary		
				8. Use: ☐ Domestic ☐ Public supply ☐ Industry ☒ Irrigation ☐ Air conditioning ☐ Stock ☐ Lawn ☐ Oil field water ☐ Other		
5. Type and color of material		From	To	9. Casing: Material Steel Height: (Above or below) Threaded ☐ Welded ☒ Surface 12 in. RMP ☐ PVC ☐ Weight 30.3 lbs./ft. Dia. 24 in. to 20 ft. depth Wall Thickness: inches or Dia. ☐ in. to ☐ ft. depth gage No. 7 gae		
top soil		0	3	10. Screen: Manufacturer's name Doerr Type Double-slot Dia. 16" (Slot) gauze 1/8 Length 28' Set between 20 ft. and 48 ft. ft. and ☐ ft. Gravel pack? yes Size range of material 3/8-200		
sand & gravel X & thin clay streaks at 20 & 33		3	47	11. Static water level: ☐ mo./day/yr. 7' 6" ft. below land surface Date 3-3-76		
Dakota clay		47	48	12. Pumping level below land surfaces: N/C ☐ ft. after ☐ hrs. pumping ☐ g.p.m. ☐ ft. after ☐ hrs. pumping ☐ g.p.m. Estimated maximum yield ☐ g.p.m.		
				13. Water sample submitted: ☐ mo./day/yr. ☐ Yes ☒ No Date ☐		
				14. Well head completion: ☐ Pitless adapter 12 inches above grade		
				15. Well grouted? yes With ☒ Neat cement ☐ Bentonite ☐ Concrete Depth: From 0 ft. to 10 ft.		
				16. Nearest source of possible contamination: NONE KNOWN ft. ☐ Direction ☐ Type ☐ Well disinfected upon completion? ☐ Yes ☒ No		
				17. Pump: ☐ Not installed Manufacturer's name Peerless FMC Model number LOMA-6 HP 40 Volts 460 Length of drop pipe 40 ft. capacity 400 g.p.m. Type: ☐ Submersible ☒ Turbine ☐ Jet ☐ Reciprocating ☐ Centrifugal ☐ Other		
18. Elevation: 1773 Topography: ☐ Hill ☐ Slope ☐ Upland ☐ Valley		19. Remarks: 28364 (APB)		20. Water well contractor's certification: This well was drilled under my jurisdiction and this report is true to the best of my knowledge and belief. Clarke Well & Eq. Inc. 185 Business name License No. Address Great Bend, KS 67530 Signed [Signature] Date 5-1-76 Authorized representative		